


Lincoln
K 2037
5-14-81

MISSISSIPPI
BOARD OF WATER COMMISSIONERS
416 North State Street
Jackson, Mississippi 39201

WATER WELL DRILLERS LOG


May 14, 1981 Grenn Water Well Cont. Lincoln
date well completed firm name county well located

| LANDOWNER: | description of formations encountered | from | to |
|---|---------------------------------------|------|----|
| Charles Hall | Sand & Gravel | 1 | 5 |
| P.O. Box 192 | white clay | 5 | 35 |
| Brookhaven, Miss. | blue clay | 35 | 55 |
| (mailing address) | white clay | 55 | 75 |
| WELL LOCATION: | sand | 75 | 95 |
| sec. 9 T. 6 N. R. 6 E | | | |
| 11 miles SW of Brookhaven | | | |
| (distance) (direction) (nearest town) | | | |
| WELL PURPOSE: home | | | |
| (home, irrigation, municipal, industrial) | | | |
| WELL COMPLETION DATA: | | | |
| (1) diameter (inches) 4 | | | |
| (2) total depth (feet) 95 | | | |
| (3) static water level (feet) 40 below top of ground. | | | |
| (4) casing PVC 85 (material) (depth) | | | |
| 4" (size) if telescope see back. | | | |
| (5) screen 10' 85' (length) (depth to top) | | | |
| .010 PVC (size) (material) | | | |
| (6) pump 1/2 sub 8 (HP) (yield gpm) | | | |
| electricity (type power) | | | |
| (7) electric log no (yes or no) | | | |
| (organization running log) | | | |
| (8) how well bottom plugged back wash valve | | | |
| DRILLERS REMARKS: | | | |

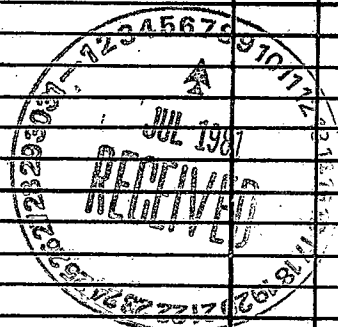

If well telescopes please sketch and show depths.

GROUND LEVEL

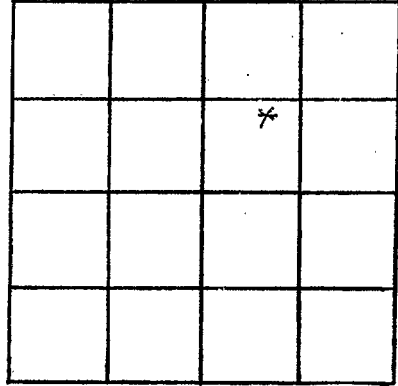

SECTION 9

Please indicate well location X.

ADDITIONAL INFORMATION

If more than one screen,
show locations of each on sketch.