

Lincoln
K 2033
8-18-81

MISSISSIPPI
BOARD OF WATER COMMISSIONERS
416 North State Street
Jackson, Mississippi 39201

WATER WELL DRILLERS LOG

8-18 1981 F. H. Smith Well Co. Lincoln
date well completed firm name county well located

LANDOWNER:	description of formations encountered	from	to
<u>R.D. Russell</u>			
<u>R.R. Brookman</u> (mailing address)	<u>Galley</u> <u>Blue clay</u> <u>concrete sand</u>	0 20 90	20 90 100
WELL LOCATION:			
sec. <u>9</u> T. <u>6</u> N R. <u>6</u> E S			
<u>AT</u> miles (distance) of <u>HORRISAWA LAKE</u> (direction) of <u>LAKE</u> (nearest town)			
WELL PURPOSE: <u>Home</u> (home, irrigation, municipal, industrial)			
WELL COMPLETION DATA:			
(1) diameter (inches) <u>4</u>			
(2) total depth (feet) <u>100</u>			
(3) static water level (feet) <u>35</u> below top of ground.			
(4) casing <u>PVC</u> , <u>92</u> (material), (depth)			
<u>4</u> if telescope see back. (size)			
(5) screen <u>8</u> , <u>92</u> (length), (depth to top)			
<u>4</u> (size), <u>PVC</u> (material)			
(6) pump <u>1/2</u> (HP), <u>10</u> (yield gpm)			
<u>Electric</u> (type power)			
(7) electric log <u>no</u> (yes or no)			
(organization running log)			
(8) how well bottom plugged <u>Sand fill</u>			
DRILLERS REMARKS:			


DEPT. OF NATURAL RESOURCES
BUREAU OF LAND & WATER RESOURCES

SEP 28 1981

RECEIVED

If well telescopes please sketch and show depths.

GROUND LEVEL

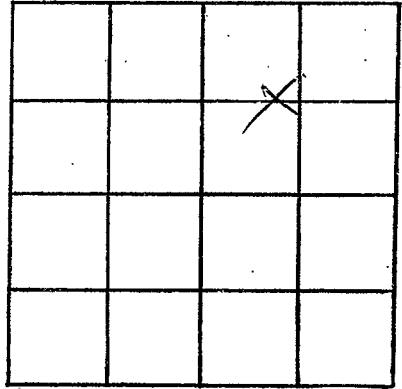

SECTION 9

Please indicate well location X.

ADDITIONAL INFORMATION

If more than one screen, show locations of each on sketch.