

Lincoln
K2037

MISSISSIPPI DEPARTMENT OF NATURAL RESOURCES

Bureau of Land and Water Resources

Southport Mall

P.O. Box 10631

Jackson, Mississippi 39209

WATER WELL DRILLERS LOG

Jan 19 19*82* *Recess weller Lincoln*
 date well completed firm name county well located

LANDOWNER:	description of formations encountered	from	to
<i>Tanya Lambert</i> <i>Rt 5 Brookhaven</i> (mailing address)			
WELL LOCATION:			
sec. <i>9</i> T. <i>6</i> N. R. <i>6</i> E <i>3</i> miles <i>W</i> of <i>West Lincoln</i> (distance) (direction) (nearest town)			
WELL PURPOSE: (home, irrigation, municipal, industrial)			
WELL COMPLETION DATA:			
(1) diameter (inches) <i>4"</i>			
(2) total depth (feet) <i>173</i>			
(3) static water level (feet) <i>128</i> below top of ground.			
(4) casing <i>plastic bottom</i> (material) (depth)			
<i>-</i> if telescope see back. (size)			
(5) screen <i>5'</i> <i>168'</i> (length) (depth to top)			
<i>4"</i> <i>plastic</i> (size) (material)			
(6) pump <i>shot</i> <i>8</i> (HP) (yield gpm)			
<i>shot</i> (type power)			
(7) electric log <i>no</i> (yes or no)			
(organization running log)			
(8) how well bottom plugged <i>Back Wash</i>			


DRILLERS REMARKS:
Pump Repassed
Customer Bad Pay!

DEPT. OF NATURAL RESOURCES
 BUREAU OF LAND & WATER RESOURCES

JUL - 1 1982
 RECEIVED

If well telescopes please sketch and show depths.

GROUND LEVEL

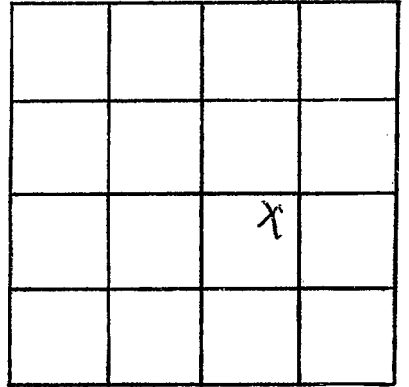

SECTION 9

Please indicate well location X.

ADDITIONAL INFORMATION

If more than one screen,
show locations of each on sketch.