

Lincoln
K
2038

MISSISSIPPI DEPARTMENT OF NATURAL RESOURCES
Bureau of Land and Water Resources
Southport Mall
P.O. Box 10631
Jackson, Mississippi 39209
WATER WELL DRILLERS LOG

June 7 1982 Green Water Well Lincoln
date well completed firm name county well located

LANDOWNER:
Michael McKlemnurry
Rt. 5, Box 105
Brookhaven, Ms.
(mailing address)

description of formations encountered	from	to
Citronelle	1	111

WELL LOCATION:
sec. 21 T 6 N R 6 E
S W
9 miles West Bogue Chitto
(distance) (direction) (nearest town)

WELL PURPOSE: home
(home, irrigation, municipal, industrial)

- WELL COMPLETION DATA:**
- diameter (inches) 4
 - total depth (feet) 111
 - static water level (feet) 45 below above top of ground.
 - casing PVC 55
(material) (depth)
4" if telescope see back.
(size)
 - screen 10' 55'
(length) (depth to top)
.010 PVC
(size) (material)
 - pump did not install
(HP) (yield gpm)

(type power)
 - electric log no
(yes or no)


(organization running log)
 - how well bottom plugged backwash valve

DRILLERS REMARKS:

DEPT. OF NATURAL RESOURCES
BUREAU OF LAND & WATER RESOURCES
AUG 20 1982
RECEIVED

If well telescopes please sketch and show depths.

GROUND LEVEL

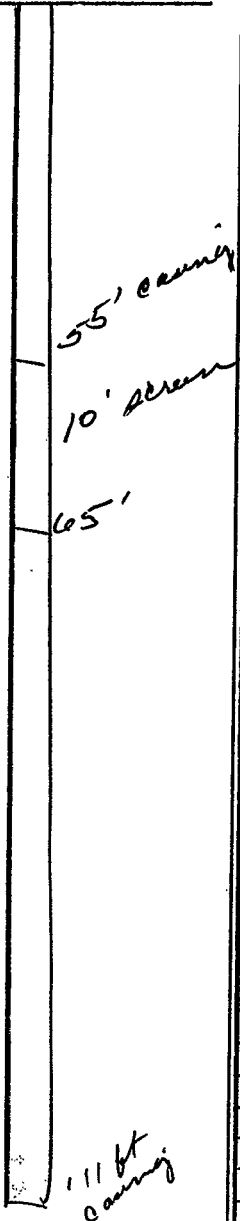

	X		

SECTION 21

Please indicate well location X.

ADDITIONAL INFORMATION

If more than one screen, show locations of each on sketch.