

Lincoln
K
2039

MISSISSIPPI DEPARTMENT OF NATURAL RESOURCES
Bureau of Land and Water Resources
Southport Mall
P.O. Box 10631
Jackson, Mississippi 39209
WATER WELL DRILLERS LOG

June 9 1982 Grenn Water Well Lincoln
date well completed firm name county well located

LANDOWNER: George King
Rt. 5, Box 177 B
Brookhaven, Ms.
(mailing address)

description of formations encountered	from	to
Clay	1	10
sand & gravel	10	20
white clay	20	35
blue clay	35	150
white clay	150	160
sand	160	220

WELL LOCATION:
sec. 24 T 6 N R 6 E
S W
7 miles W of Bogue Chitto
(distance) (direction) (nearest town)

WELL PURPOSE: home
(home, irrigation, municipal, industrial)

- WELL COMPLETION DATA:
- (1) diameter (inches) 4
 - (2) total depth (feet) 220
 - (3) static water level (feet) 73 below above top of ground.
 - (4) casing PVC 210
(material) (depth)
4" if telescope see back.
(size)
 - (5) screen 10' 210'
(length) (depth to top)
.010 PVC
(size) (material)
 - (6) pump 1 Sub 20
(HP) (yield gpm)
electricity
(type power)
 - (7) electric log no
(yes or no)
(organization running log)
 - (8) how well bottom plugged back wash valve

DRILLERS REMARKS:


DEPT. OF NATURAL RESOURCES
BUREAU OF LAND & WATER RESOURCES

AUG 20 1982

RECEIVED

If well telescopes please sketch and show depths.

GROUND LEVEL

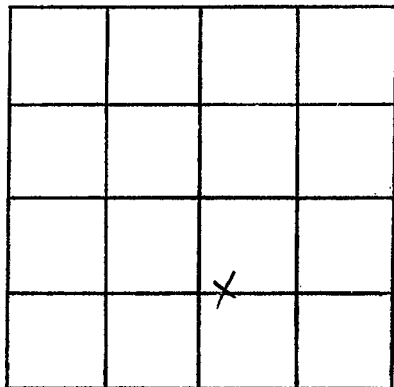

SECTION 24

Please indicate well location X.

ADDITIONAL INFORMATION

If more than one screen,
show locations of each on sketch.