

Lincoln
K 2048

MISSISSIPPI DEPARTMENT OF NATURAL RESOURCES
Bureau of Land and Water Resources
Southport Mall
P.O. Box 10631
Jackson, Mississippi 39209
WATER WELL DRILLERS LOG

Aug. 25 82 Grem Water Well Lincoln
date well completed firm name county well located

LANDOWNER: <u>Joyce Herring</u>	description of fomations encountered	from	to
<u>Rt. 5, Box 170B</u>			
<u>Brookhaven, Ms.</u>	<u>Clay</u>	<u>1</u>	<u>20</u>
<u>(mailing address)</u>	<u>sand</u>	<u>20</u>	<u>60</u>
	<u>white clay</u>	<u>60</u>	<u>90</u>
	<u>sand</u>	<u>90</u>	<u>143</u>

WELL LOCATION:
sec. 5 T. 6 N. R. 6 E
S W
10 miles SW of Brookhaven
(distance) (direction) (nearest town)

WELL PURPOSE: none
(home, irrigation, municipal, industrial)

- WELL COMPLETION DATA:**
- (1) diameter (inches) 4
 - (2) total depth (feet) 143
 - (3) static water level (feet) 117 below top of ground.
 - (4) casing PVC, 133,
(material) (depth)
4" if telescope see back.
(size)
 - (5) screen 10", 133"
(length) (depth to top)
.010 PVC
(size) (material)
 - (6) pump 3/4 sub 8
(HP) (yield gpm)
electricity
(type power)
 - (7) electric log no
(yes or no)
(organization running log)
 - (8) how well bottom plugged back wash valve

DRILLERS REMARKS:


DEPT. OF NATURAL RESOURCES
BUREAU OF LAND & WATER RESOURCES

NOV 23 1982

RECEIVED

If well telescopes please sketch and show depths.

GROUND LEVEL

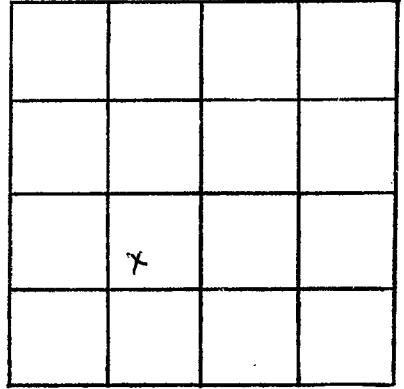

SECTION 5

Please indicate well location X.

ADDITIONAL INFORMATION

If more than one screen,
show locations of each on sketch.