

Lincoln  
R 2041

MISSISSIPPI DEPARTMENT OF NATURAL RESOURCES  
Bureau of Land and Water Resources  
Southport Mall  
P.O. Box 10631  
Jackson, Mississippi 39209  
**WATER WELL DRILLERS LOG**

Aug. 9 1982 Grenn Water Well Lincoln  
date well completed firm name county well located

LANDOWNER: Fred Herring

Rt. 5, Box 168

Brookhaven, Ms.

(mailing address)

description of formations encountered

from

to

Clay

1

20

sand & gravel

20

55

white clay

55

135

Sand

135

180

WELL LOCATION:

sec. 5 T 6 N R 6 E  
S W

10 miles SW of Brookhaven  
(distance) (direction) (nearest town)

WELL PURPOSE: home  
(home, irrigation, municipal, industrial)

WELL COMPLETION DATA:

- (1) diameter (inches) 4  
(2) total depth (feet) 180  
(3) static water level (feet) 134 below top of ground.

(4) casing PVC 170  
(material) (depth)  
4"  
(size) if telescope see back.

(5) screen 10' 170'  
(length) (depth to top)  
.010 PVC  
(size) (material)

(6) pump 1 sub 10  
(HP) (yield gpm)

electricity  
(type power)

(7) electric log no  
(yes or no)

(organization running log)

(8) how well bottom plugged  
back wash valve

DRILLERS REMARKS:


DEPT. OF NATURAL RESOURCES  
BUREAU OF LAND & WATER RESOURCES

NOV 23 1982

RECEIVED

If well telescopes please sketch and show depths.

GROUND LEVEL

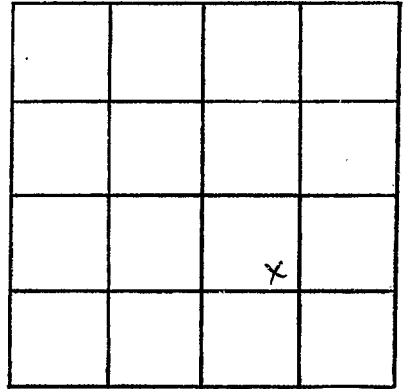

SECTION 5

Please indicate well location X.

ADDITIONAL INFORMATION

If more than one screen,  
show locations of each on sketch.