

Lincoln  
R 2042

MISSISSIPPI DEPARTMENT OF NATURAL RESOURCES  
Bureau of Land and Water Resources  
Southport Mall  
P.O. Box 10631  
Jackson, Mississippi 39209  
WATER WELL DRILLERS LOG

Sept. 16 19 82 Grenn Water Well Lincoln  
date well completed firm name county well located

LANDOWNER: <u>Louis Nichols</u>	description of formations encountered	from	to
<u>Rt. 5, Box 103J</u>			
<u>Brookhaven, Ms.</u>	<u>Clay</u>	<u>1</u>	<u>10</u>
<u>(mailing address)</u>	<u>sand &amp; gravel</u>	<u>10</u>	<u>20</u>
<u>WELL LOCATION:</u>	<u>white clay</u>	<u>20</u>	<u>40</u>
<u>sec. 9 T 6 N R 6 E</u>	<u>blue clay</u>	<u>40</u>	<u>60</u>
<u>S W</u>	<u>white clay</u>	<u>60</u>	<u>70</u>
<u>12 miles SW of Brookhaven</u>	<u>sand</u>	<u>70</u>	<u>100</u>
<u>(distance) (direction) (nearest town)</u>			
<u>WELL PURPOSE: home</u>			
<u>(home, irrigation, municipal, industrial)</u>			
<u>WELL COMPLETION DATA:</u>			
(1) diameter (inches) <u>4</u>			
(2) total depth (feet) <u>100</u>			
(3) static water level (feet) <u>34</u> below above top of ground.			
(4) casing <u>PVC</u> <u>90'</u>			
<u>(material) (depth)</u>			
<u>4"</u> if telescope see back.			
<u>(size)</u>			
(5) screen <u>10'</u> <u>90'</u>			
<u>(length) (depth to top)</u>			
<u>.010 PVC</u>			
<u>(size) (material)</u>			
(6) pump <u>did not install</u>			
<u>(HP) (yield gpm)</u>			
<u>(type power)</u>			
(7) electric log <u>no</u>			
<u>(yes or no)</u>			
<u>(organization running log)</u>			
(8) how well bottom plugged <u>back wash valve</u>			

DRILLERS REMARKS:


DEPT. OF NATURAL RESOURCES  
BUREAU OF LAND & WATER RESOURCES

NOV 23 1982

RECEIVED

If well telescopes please sketch and show depths.

GROUND LEVEL

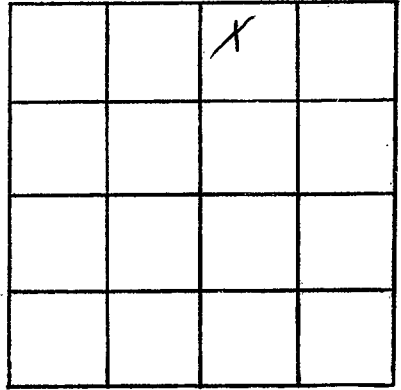

SECTION 9

Please indicate well location X.

ADDITIONAL INFORMATION

If more than one screen,  
show locations of each on sketch.