

Lincoln
K
2046

MISSISSIPPI DEPARTMENT OF NATURAL RESOURCES
 Bureau of Land and Water Resources
 Southport Mall
 P.O. Box 10631
 Jackson, Mississippi 39209
WATER WELL DRILLERS LOG

May 24 19 83 Grenn Water Well Lincoln
 date well completed firm name county well located

LANDOWNER:	description of formations encountered	from	to
W. L. Cupit	Slay	1	15
Rt. 5, Box 220	sand & gravel	15	40
Brookhaven, Ms.	white clay	40	55
(mailing address)	blue clay	55	190
WELL LOCATION:	white clay	190	200
sec. <u>21</u> T. <u>6</u> N. R. <u>6</u> E	sand	200	225
S W			
<u>11</u> miles SW of Brookhaven			
(distance) (direction) (nearest town)			
WELL PURPOSE: home			
(home, irrigation, municipal, industrial)			
WELL COMPLETION DATA:			
(1) diameter (inches) <u>4</u>			
(2) total depth (feet) <u>225</u>			
(3) static water level (feet) <u>120</u> below above top of ground.			
(4) casing <u>PVC</u> , <u>215</u>			
(material) (depth)			
<u>4"</u> If telescope see back.			
(size)			
(5) screen <u>10'</u> , <u>215'</u>			
(length) (depth to top)			
<u>.010</u> , <u>PVC</u>			
(size) (material)			
(6) pump <u>3/4</u> sub <u>8</u>			
(HP) (yield gpm)			
<u>electricity</u>			
(type power)			
(7) electric log <u>no</u>			
(yes or no)			
(organization running log)			
(8) how well bottom plugged _____			
<u>back wash valve</u>			
DRILLERS REMARKS:			


DEPT. OF NATURAL RESOURCES
 BUREAU OF LAND & WATER RESOURCES

AUG 30 1983

RECEIVED

If well telescopes please sketch and show depths.

GROUND LEVEL

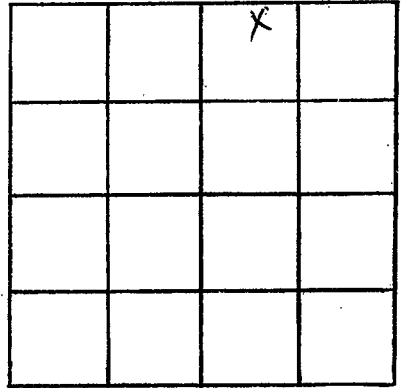

SECTION 21

Please indicate well location X.

ADDITIONAL INFORMATION

If more than one screen, show locations of each on sketch.