

Lincoln
K
2049

MISSISSIPPI DEPARTMENT OF NATURAL RESOURCES
 Bureau of Land and Water Resources
 Southport Mall
 P.O. Box 10631
 Jackson, Mississippi 39209
WATER WELL DRILLERS LOG

4-23 19 84 Gretn Water Well Lincoln
 date well completed firm name county well located


LANDOWNER:	description of formations encountered	from	to
<u>Bob Cambell</u>	<u>Clay</u>	<u>1</u>	<u>15</u>
<u>Rt. 5, Box 715 A</u>	<u>sand & gravel</u>	<u>15</u>	<u>25</u>
<u>Brookhaven, Ms.</u>	<u>white clay</u>	<u>25</u>	<u>40</u>
(mailing address)	<u>blue clay</u>	<u>40</u>	<u>75</u>
<u>WELL LOCATION:</u>	<u>white clay</u>	<u>75</u>	<u>95</u>
sec. <u>4</u> T. <u>6</u> N. R. <u>6</u> E	<u>sand</u>	<u>95</u>	<u>146</u>
S W			
<u>7</u> miles SW of <u>Brookhaven</u>			
(distance) (direction) (nearest town)			
<u>WELL PURPOSE: home</u>			
(home, irrigation, municipal, industrial)			
<u>WELL COMPLETION DATA:</u>			
(1) diameter (inches) <u>4</u>			
(2) total depth (feet) <u>146</u>			
(3) static water level (feet) <u>80</u> below above top of ground.			
(4) casing <u>PVC</u> <u>136'</u>			
(material) (depth)			
<u>4"</u>			
(size) if telescope see back.			
(5) screen <u>10'</u> <u>136'</u>			
(length) (depth to top)			
<u>.010</u> <u>PVC</u>			
(size) (material)			
(6) pump <u>did not install</u>			
(HP) (yield gpm)			
(type power)			
(7) electric log <u>no</u>			
(yes or no)			
(organization running log)			
(8) how well bottom plugged <u>back wash valve</u>			

DRILLERS REMARKS:

DEPT. OF NATURAL RESOURCES
 BUREAU OF LAND & WATER RESOURCES
 JUN 11 1984
RECEIVED

If well telescopes please sketch and show depths.

GROUND LEVEL

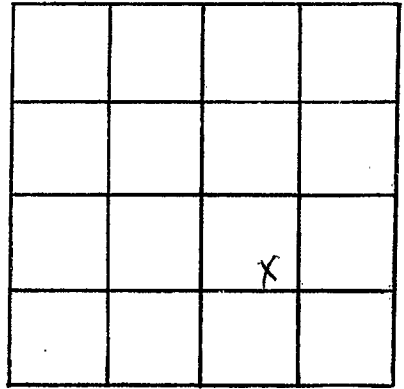

SECTION 4

Please indicate well location X.

ADDITIONAL INFORMATION

If more than one screen,
show locations of each on sketch.