

MISSISSIPPI DEPARTMENT OF NATURAL RESOURCES

Bureau of Land and Water Resources

Southport Mall

P.O. Box 10631

Jackson, Mississippi 39209

WATER WELL DRILLERS LOG

Lincoln
K 2053

Sept. 26, 1985 Grenn Water Well Lincoln
date well completed firm name county well located

LANDOWNER: Jim Arnold
Rt. 5, Box #82
Brookhaven, Ms.
(mailing address)

description of formations encountered	from	to
clay	1	20
sand & gravel	20	57
white clay	57	77
blue clay	77	137
white clay	137	160
sand	160	173

WELL LOCATION:
sec. 3 T. 6 N. R. 6 E
S W
9 miles SW of Brookhaven
(distance) (direction) (nearest town)

WELL PURPOSE: home
(home, irrigation, municipal, industrial)


WELL COMPLETION DATA:

- (1) diameter (inches) 4
- (2) total depth (feet) 173
- (3) static water level (feet) 108 below above top of ground.
- (4) casing PVC, 163',
(material) (depth)
.010
(size) if telescope see back.
- (5) screen 10', 163'
(length) (depth to top)
.010 PVC
(size) (material)
- (6) pump did not install
(HP) (yield gpm)

(type power)
- (7) electric log no
(yes or no)

(organization running log)
- (8) how well bottom plugged back wash valve


DRILLERS REMARKS:

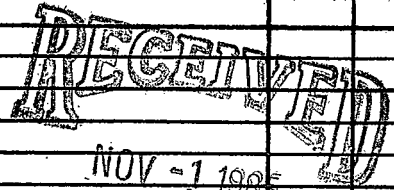

Department of Natural Resources
Bureau of Land & Water Resources

If well telescopes please sketch and show depths.

GROUND LEVEL

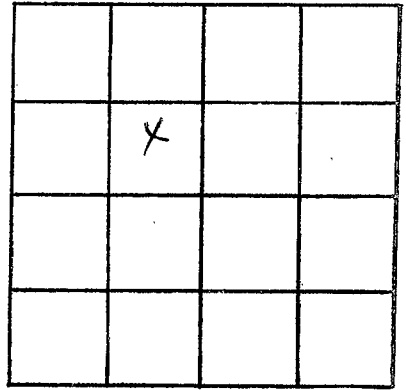

SECTION 3

Please indicate well location X.

ADDITIONAL INFORMATION

If more than one screen,
show locations of each on sketch.