

Lincoln
R 2054

MISSISSIPPI DEPARTMENT OF NATURAL RESOURCES
 Bureau of Land and Water Resources
 Southport Mall
 P.O. Box 10631
 Jackson, Mississippi 39209
WATER WELL DRILLERS LOG

3-6 1986 Gretn Water Well Lincoln
 date well completed firm name county well located

LANDOWNER:
 Richard Baughman
 Rt. 5, Box 716A
 Brookhaven, Ms.
 (mailing address)

description of formations encountered	from	to
clay	1	20
sand & gravel	20	30
white clay	30	50
blue clay	50	75
white clay	75	85
sand	85	123

WELL LOCATION:
 sec 9 T 6 N R 6 E
 S W
 9 miles SW of Brookhaven
 (distance) (direction) (nearest town)

WELL PURPOSE: home
 (home, irrigation, municipal, industrial)

WELL COMPLETION DATA:

(1) diameter (inches) 4

(2) total depth (feet) 123

(3) static water level (feet) 55 below top of ground.


(4) casing PVC 113'
 (material) (depth)
 4" if telescope see back.
 (size)

(5) screen 10' 113'
 (length) (depth to top)
 .010 PVC
 (size) (material)

(6) pump 1/2 sub 10
 (HP) (yield gpm)
 electricity
 (type power)

(7) electric log no
 (yes or no)
 (organization running log)

(8) how well bottom plugged back wash valve

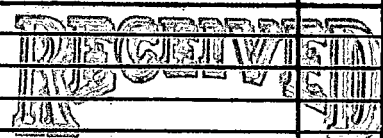


ADD 8 1986
 APR 5 1986

Department of Natural Resources
 BUREAU OF LAND & WATER RESOURCES

DRILLERS REMARKS:

If well telescopes please sketch and show depths.

GROUND LEVEL

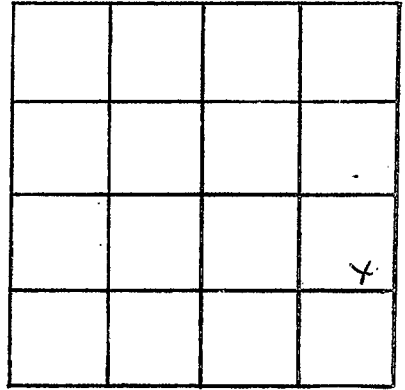

SECTION 9

Please indicate well location X.

ADDITIONAL INFORMATION

If more than one screen,
show locations of each on sketch.