

MISSISSIPPI DEPARTMENT OF NATURAL RESOURCES

Bureau of Land and Water Resources

Southport Mall

P.O. Box 10631

Jackson, Mississippi 39209

WATER WELL DRILLERS LOG

LINCOLN  
R 2055


Mar. 7 19 86 Grenn Water Well Lincoln  
date well completed firm name county well located

LANDOWNER: Brady Davis Rt. 5, Box 663	description of formations encountered Citronelles	from 1	to 68
Brookhaven, Ms. (mailing address)			
WELL LOCATION: sec. <u>27</u> <u>6</u> N R <u>6</u> E S W 9 miles W of Bogue Chitto (distance) (direction) (nearest town)			
WELL PURPOSE: home (home, irrigation, municipal, industrial)			
WELL COMPLETION DATA:			
(1) diameter (inches) <u>4</u>			
(2) total depth (feet) <u>68</u>			
(3) static water level (feet) <u>25</u> below top of ground.			
(4) casing <u>PVC</u> <u>58</u> (material) (depth) <u>4"</u> (size) if telescope see back.			
(5) screen <u>10'</u> <u>58'</u> (length) (depth to top) <u>.010</u> <u>PVC</u> (size) (material)			
(6) pump <u>1/2 sub</u> <u>10</u> (HP) (yield gpm) electricity (type power)			
(7) electric log <u>no</u> (yes or no)			
(organization running log)			
(8) how well bottom plugged <u>back wash valve</u>			
DRILLERS REMARKS:			

MISSISSIPPI DEPARTMENT OF NATURAL RESOURCES  
BUREAU OF LAND AND WATER RESOURCES  
APR 25 1986  
Department of Natural Resources  
Bureau of Land & Water Resources

If well telescopes please sketch and show depths.

GROUND LEVEL

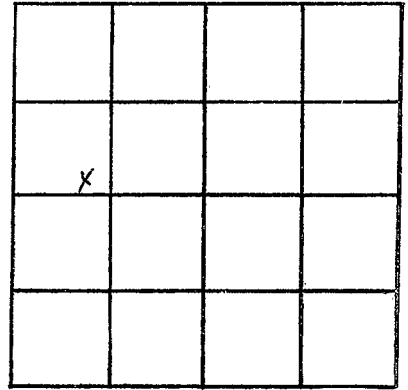

SECTION 27

Please indicate well location X.

ADDITIONAL INFORMATION

If more than one screen,  
show locations of each on sketch.