

MISSISSIPPI DEPARTMENT OF NATURAL RESOURCES
Bureau of Land and Water Resources
 Southport Mall
 P.O. Box 10631
 Jackson, Mississippi 39209
WATER WELL DRILLERS LOG

LINCOLN
K
2056

May 13 1986 Grenn Water Well Lincoln
 date well completed firm name county well located

LANDOWNER: Ollie Murray	description of formations encountered	from	to
Route 4		Citronelle	1
Bogue Chitto, Ms. (mailing address)			
WELL LOCATION: sec. 34 T. 6 N R. 6 E S W 8 miles West of Bogue Chitto (distance) (direction) (nearest town)			
WELL PURPOSE: home (home, irrigation, municipal, industrial)			
WELL COMPLETION DATA:			
(1) diameter (inches) 4			
(2) total depth (feet) 108			
(3) static water level (feet) 59 below top of ground. above			
(4) casing PVC 98' (material) (depth) .010 if telescope see back. (size)			
(5) screen 10' 98' (length) (depth to top) .010 PVC (size) (material)			
(6) pump 1/2 sub 10 (HP) (yield gpm) electricity (type power)			
(7) electric log n0 (yes or no)			
(organization running log)			
(8) how well bottom plugged back wash valve			


RECEIVED
 JUN 27 1986

Department of Natural Resources
 Bureau of Land & Water Resources

DRILLERS REMARKS:

If well telescopes please
sketch and show depths.

GROUND LEVEL

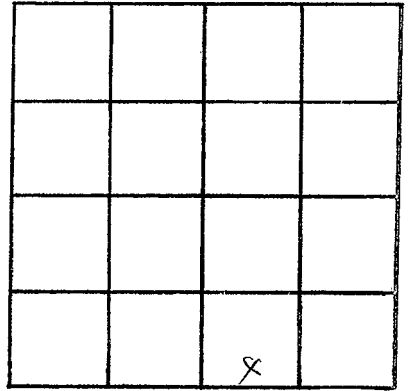

SECTION 34

Please indicate well location X.

ADDITIONAL INFORMATION

If more than one screen,
show locations of each on sketch.