

MISSISSIPPI DEPARTMENT OF NATURAL RESOURCES
Bureau of Land and Water Resources
 Southport Mall
 P.O. Box 10631
 Jackson, Mississippi 39209
WATER WELL DRILLERS LOG

LINCOLN
K
2057

May 9 1986 Grenn Water Well Lincoln
 date well completed firm name county well located

LANDOWNER: Jerry D. Rice	description of formations encountered	from	to
Route 4 Brookhaven, Ms. (mailing address)			
WELL LOCATION: sec. 10 6 N R 6 E S W 9 miles SE of Brookhaven (distance) (direction) (nearest town)			
WELL PURPOSE: home (home, irrigation, municipal, industrial)			
WELL COMPLETION DATA:			
(1) diameter (inches) 4"			
(2) total depth (feet) 128'			
(3) static water level (feet) 47' below above top of ground.			
(4) casing PVC, 118' (material) (depth) 4" if telescope see back. (size)			
(5) screen 10' 118' (length) (depth to top) .010 PVC (size) (material)			
(6) pump 1/2 sub 10 (HP) (yield gpm) electricity (type power)			
(7) electric log no (yes or no) (organization running log)			
(8) how well bottom plugged back wash valve			


RECEIVED
TRACENT
 JUN 27 1986

Department of Natural Resources
 Bureau of Land & Water

DRILLERS REMARKS:

If well telescopes please sketch and show depths.

GROUND LEVEL

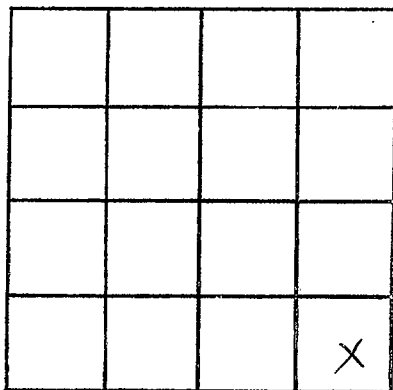

SECTION 10

Please indicate well location X.

ADDITIONAL INFORMATION

If more than one screen,
show locations of each on sketch.