

LINCOLN
K
2058

MISSISSIPPI DEPARTMENT OF NATURAL RESOURCES
 Bureau of Land and Water Resources
 Southport Mall
 P.O. Box 10631
 Jackson, Mississippi 39209
WATER WELL DRILLERS LOG

5/23 1986 Jerry Guins Water Well Serv. Lincoln
 date well completed firm name county well located

LANDOWNER: Elnice (Red) Nettles
Rt. 5 Box 662
Beekhaven, Ms 39601
 (mailing address)


description of formations encountered	from	to
<u>White Sand</u>	<u>0</u>	<u>15</u>
<u>Sand & Pea Gravel</u>	<u>15</u>	<u>60</u>
<u>Clay</u>	<u>60</u>	<u>70</u>

WELL LOCATION:
sec 23 T 6N R 6E
S W
10 miles SW of Beekhaven
 (distance) (direction) (nearest town)

WELL PURPOSE: Home
 (home, irrigation, municipal, industrial)


- WELL COMPLETION DATA:**
- diameter (inches) 4"
 - total depth (feet) 70'
 - static water level (feet) 25' below above top of ground.
 - casing PVC 60'
 (material) (depth)
4" if telescope see back.
 (size)
 - screen 20' 40'
 (length) (depth to top)
4" PVC
 (size) (material)
 - pump 1/2 sub 10
 (HP) (yield gpm)
electricity
 (type power)
 - electric log No
 (yes or no)
 (organization running log)
 - how well bottom plugged Backwash
valve

DRILLERS REMARKS:

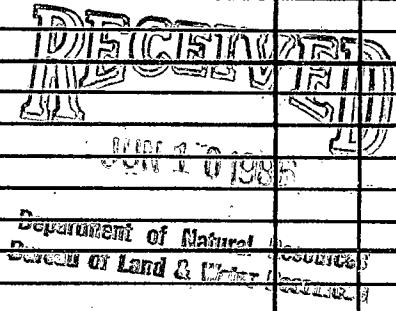

If well telescopes please sketch and show depths.

GROUND LEVEL

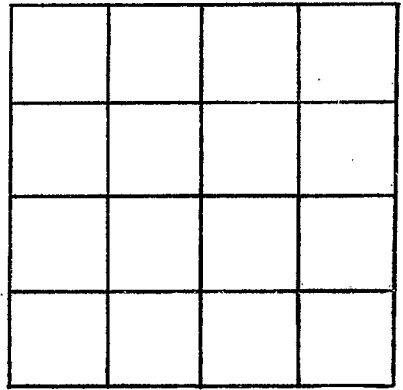

SECTION _____

Please indicate well location X.

ADDITIONAL INFORMATION

If more than one screen, show locations of each on sketch.