

LINCOLN  
K 2059

MISSISSIPPI DEPARTMENT OF NATURAL RESOURCES  
Bureau of Land and Water Resources  
Southport Mall  
P.O. Box 10631  
Jackson, Mississippi 39209  
WATER WELL DRILLERS LOG

7/28  
date well completed

1986 Eastley Plumbing Co  
firm name

W. GUINN DRILLERS  
Lincoln  
county well located

LANDOWNER: Fay Richardson

RT 4 BOX 101A

Boguech. Tte, MS. 39659  
(mailing address)

WELL LOCATION:

sec. 4 T 6 N R 6 E  
5 miles SW of B'Haven  
(distance) (direction) (nearest town)

WELL PURPOSE: Home  
(home, irrigation, municipal, industrial)

WELL COMPLETION DATA:

- (1) diameter (inches) 4"
  - (2) total depth (feet) 88'
  - (3) static water level (feet) 62' below above top of ground.
  - (4) casing PVC, 78' (material) (depth)  
4" (size) if telescope see back.
  - (5) screen 10' 78' (length) (depth to top)  
4" PVC (size) (material)
  - (6) pump 1/2 10 (HP) (yield gpm)  
electricity (type power)
  - (7) electric log No (yes or no)
- (organization running log)

(8) how well bottom plugged:  
Backwash Valve

DRILLERS REMARKS:

description of formations encountered

from to


Clay	0	50
Sand & Gravel	50	88

RECEIVED  
DEC 21 1986

Department of Natural Resources  
Bureau of Land & Water Resources

If well telescopes please sketch and show depths.

GROUND LEVEL

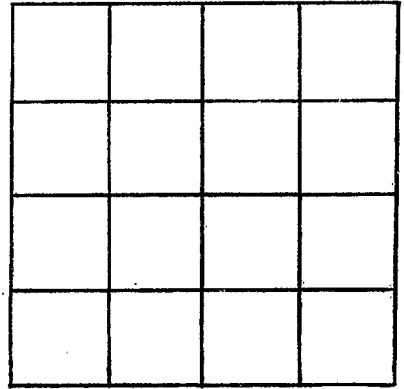

SECTION \_\_\_\_\_

Please indicate well location X.

ADDITIONAL INFORMATION

If more than one screen,  
show locations of each on sketch.