

MISSISSIPPI DEPARTMENT OF NATURAL RESOURCES

Bureau of Land and Water Resources

Southport Mall

P.O. Box 10631

Jackson, Mississippi 39209

WATER WELL DRILLERS LOG

LINCOLN  
K 2061

10/4 1986  
date well completed

Easley Plumbing Co @ Crown  
firm name

Lincoln  
county well located

LANDOWNER: Peggy Pepper  
RT 5 Box 708  
BROOKHAVEN, MS. 39601  
(mailing address)

description of formations encountered	from	to
Clay	0	40
Gravel	40	50
Clay	50	170
Sand	170	190

WELL LOCATION:  
sec 4 T 6 N R 6 E  
10 miles SE of Brookhaven  
(distance) (direction) (nearest town)

WELL PURPOSE: Home  
(home, irrigation, municipal, industrial)

WELL COMPLETION DATA:

- (1) diameter (inches) 4"
  - (2) total depth (feet) 190'
  - (3) static water level (feet) 46' below top of ground.
  - (4) casing PVC, 180' (material), (depth),  
4" (size) if telescope see back.
  - (5) screen 10', 180' (length), (depth to top)  
4" (size), PVC (material)
  - (6) pump 1 (HP), 10 (yield gpm)  
electricity (type power)
  - (7) electric log No (yes or no)
- (organization running log)

(8) how well bottom plugged Backwash Valve

DRILLERS REMARKS:


RECEIVED

DEC 24 1986

Department of Natural Resources  
Bureau of Land & Water Resources

If well telescopes please sketch and show depths.

GROUND LEVEL

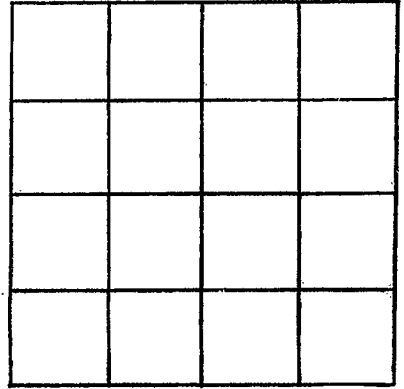

SECTION \_\_\_\_\_

Please indicate well location X.

ADDITIONAL INFORMATION

If more than one screen,  
show locations of each on sketch.