

# MISSISSIPPI DEPARTMENT OF NATURAL RESOURCES

Bureau of Land and Water Resources

COUNTY WELL LOCATED <i>Lincoln</i>	
WELL NUMBER <i>K 2064</i>	CODED
DATE WELL COMPLETED <i>87</i>	

PERMIT NUMBER <i>0287</i>
NAME OF DRILLING FIRM <i>Peenus Well Service</i>

P.O. Box 10631  
Jackson, Mississippi 39209  
**WATER WELL DRILLERS LOG**

NAME & MAILING ADDRESS OF LANDOWNER <i>Joel Smith</i> <i>West Lincoln miss</i>			
WELL LOCATION: SEC _____ TOWNSHIP <i>N 6 S</i> RANGE <i>6 W</i>			
DISTANCE <i>1/2</i> Miles	DIRECTION <i>north</i> of	NEAREST TOWN <i>West Lincoln</i>	
OTHER LANDMARK <i>near west Lincoln school</i>			
WELL PURPOSE (Home, Irrigation, Municipal, Industrial, Fish Pond, etc.)			

<b>PUMP DATA</b>		
PUMP TYPE (Circle One): <u>Submersible</u> Turbine, Jet, Flowing Well, Other (Describe) _____		
POWER TYPE (Circle One): <u>Electric</u> Tractor, Diesel, Gasoline, Butane, Other (Describe) _____		
Pump Capacity (GPM) <i>10</i>	No. of Stages <i>8</i>	Setting Depth <i>75</i> FT.
PUMP TEST Well yielded <i>10</i> GPM with a drawdown of <i>0</i> ft. after <i>1</i> hours of pumping		


<b>WELL DATA</b>		
Well Depth <i>80</i>	Casing Diameter (In.) <i>4"</i>	Casing Length (Ft.) <i>70</i>
Type of Casing <i>plastic</i>	Hole Depth <i>80</i>	Depth to Static Water Level <i>57ft</i>
TYPE OF COMPLETION: (Circle One or More): Gravel Packed, Underreamed, Telescoped, <u>Natural Development</u> , Open Hole, Other (Describe) _____		
Top of Lap Pipe or Reduction in Casing  FEET _____ IF TELESCOPED OR MORE THAN ONE SCREEN: USE BACK PAGE		

<b>LOG DATA</b>	
TYPE OF LOG RUN (Circle One): No Log Run, Electric, Gamma Ray, Density, Sonic, Neutron, Other (Describe) _____	
Name of Organization Running Log	

<b>SCREEN DATA</b>		
Diameter - Inches <i>4"</i>	Length - Feet <i>10</i>	Slot Size - Inches <i>.012</i>
Screen Type <i>P.V.C.</i>	Depth to Bottom - Feet <i>80ft</i>	

<b>GEOLOGIC DATA (Office Use Only)</b>			
Surface Elev.	Geologic Unit	Unit Thickness	Depth to Top
Subs. SWL	Date	Analysis	Aquifer Test
Driller's Remarks			


DESCRIPTION OF FORMATIONS ENCOUNTERED	FROM	TO
<i>clay</i>	<i>0</i>	<i>18</i>
<i>red sand</i>	<i>18</i>	<i>68</i>
<i>small gravel &amp; sand</i>	<i>68</i>	<i>80</i>

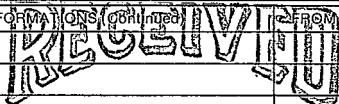 JUN 29 1987 Department of Natural Resources Bureau of Land & Water Resources

IF MORE SPACE IS NEEDED, USE BACK

If well telescopes please  
sketch and show depths.

GROUND LEVEL

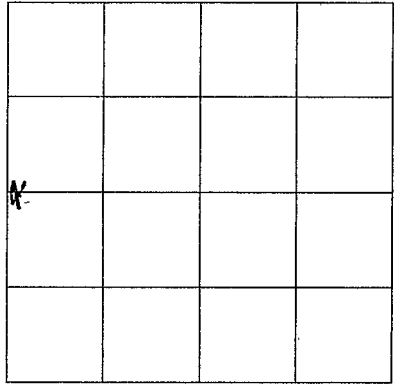

SECTION 12

Please indicate well location X.

ADDITIONAL INFORMATION

If more than one screen,  
show location of each on sketch.