

MISSISSIPPI DEPARTMENT OF NATURAL RESOURCES
Bureau of Land and Water Resources

P.O. Box 10631
Jackson, Mississippi 39209
WATER WELL DRILLERS LOG

COUNTY WELL LOCATED <i>Lawrence</i>	
WELL NUMBER <i>R 2069</i>	CODED
DATE WELL COMPLETED <i>11-18-87</i>	

PERMIT NUMBER
NAME OF DRILLING FIRM <i>Green Water Well + Supply</i>

NAME & MAILING ADDRESS OF LANDOWNER <i>Henry Ballard</i>		
<i>Rt 2 Box 100 A</i>		
<i>Monticello, ms.</i>		
WELL LOCATION: SEC	TOWNSHIP	RANGE
<i>28</i>	<i>6 S</i>	<i>11 E</i>
DISTANCE <i>6</i> Miles	DIRECTION <i>South</i> of	NEAREST TOWN <i>Monticello</i>
OTHER LANDMARK		
WELL PURPOSE: Home, Irrigation, Municipal, Industrial, Fish Pond, etc. <i>home</i>		

PUMP DATA		
PUMP TYPE (Circle One): <u>Submersible</u> , Turbine, Jet, Flowing Well, Other (Describe)		
POWER TYPE (Circle One): <u>Electric</u> , Tractor, Diesel, Gasoline, Butane, Other (Describe)		
Pump Capacity (GPM) <i>10</i>	No. of Stages <i>15</i>	Setting Depth <i>127</i> FT.
PUMP TEST		
Well yielded <i>7</i> GPM with a drawdown of <i>2</i> ft. after <i>10 min</i> hours of pumping		

WELL DATA		
Well Depth <i>148</i>	Casing Diameter (In.) <i>4</i>	Casing Length (Ft.) <i>138</i>
Type of Casing <i>PVC</i>	Hole Depth <i>160</i>	Depth to Static Water Level <i>100</i>
TYPE OF COMPLETION: (Circle One or More): <u>Gravel Packed</u> , Underreamed, Telescoped, Natural Development, Open Hole, Other		
Top of Lap Pipe or Reduction in Casing FEET IF TELESKOPED OR MORE THAN ONE SCREEN: USE BACK PAGE		

LOG DATA	
TYPE OF LOG RUN (Circle One): <u>No Log Run</u> , Electric, Gamma Ray, Density, Sonic, Neutron, Other (Describe)	
Name of Organization Running Log	

SCREEN DATA		
Diameter - Inches <i>4</i>	Length - Feet <i>10</i>	Slot Size - Inches <i>10/10</i>
Screen Type <i>PVC</i>	Depth to Bottom - Feet <i>148</i>	


GEOLOGIC DATA (Office Use Only)			
Surface Elev.	Geologic Unit	Unit Thickness	Depth to Top
Subs. SWL	Date	Analysis	Aquifer Test
Driller's Remarks			

DESCRIPTION OF FORMATIONS ENCOUNTERED	FROM	TO	FORMATIONS (Continued)	FROM	TO
<i>Citronelle Clay</i>	<i>1</i>	<i>157</i>	RECEIVED <i>APR 25 1988</i> Department of Natural Resources Bureau of Land & Water Resources		
	<i>157</i>	<i>160</i>			

IF MORE SPACE IS NEEDED, USE BACK

If well telescopes please
sketch and show depths.

GROUND LEVEL

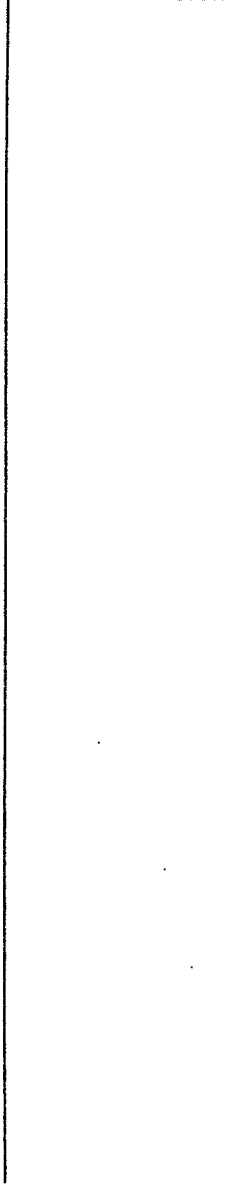


A large vertical rectangular area intended for sketching well details. It is bounded on the top by a horizontal line labeled 'GROUND LEVEL' and on the left by a vertical line. The rest of the area is blank.

7			

SECTION 28

Please indicate well location X.

ADDITIONAL INFORMATION

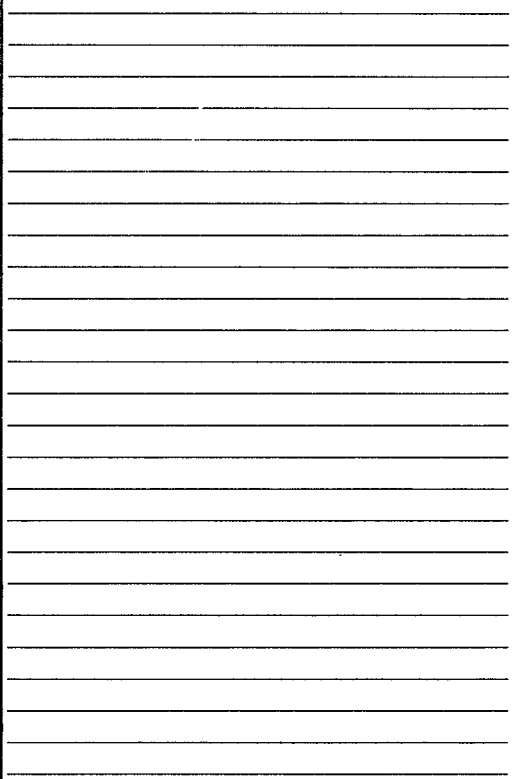

A series of horizontal lines provided for writing additional information. The lines are spaced evenly and cover the right side of the lower half of the page.

If more than one screen,
show location of each on sketch.