

MISSISSIPPI DEPARTMENT OF NATURAL RESOURCES

Bureau of Land and Water Resources

Southport Mall

P.O. Box 10631

Jackson, Mississippi 39209

WATER WELL DRILLERS LOG

Lincoln  
K2081

July 23 1990 Jeff Smith Lincoln  
date well completed firm name county well located

LANDOWNER: Jeff Smith description of formations encountered from to  
RR. Bozwell Ct. Bors. (mailing address) Red clay 0 12  
Hard sand 12 50  
White blue clay 50 215  
Coarse sand & silt 215 240

WELL LOCATION:  
sec. 22 T 6 N R 6 E  
S W  
4 miles W of W Lincoln  
(distance) (direction) (nearest town)

WELL PURPOSE: Home  
(home, irrigation, municipal, industrial)

WELL COMPLETION DATA:  
(1) diameter (inches) 4  
(2) total depth (feet) 240  
(3) static water level (feet) 140 below above top of ground.  
(4) casing PVC, 230,  
(material) (depth)  
4 if telescope see back.  
(size)  
(5) screen 10, 230  
(length) (depth to top)  
4, PVC  
(size) (material)  
(6) pump 3/4, 12  
(HP) (yield gpm)  
alm  
(type power)  
(7) electric log No  
(yes or no)  
(organization running log)  
(8) how well bottom plugged Lead flk

RECEIVED


AUG 17 1990

Department of Natural Resources  
Bureau of Land & Water Resources

DRILLERS REMARKS:

If well telescopes please sketch and show depths.

GROUND LEVEL

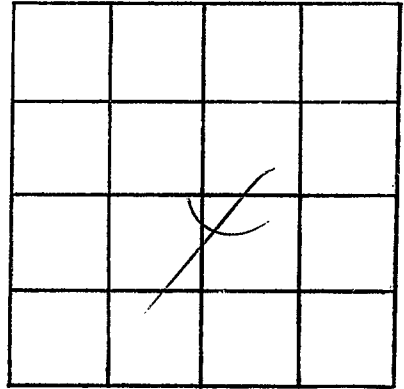

SECTION 22

Please indicate well location X.

ADDITIONAL INFORMATION

If more than one screen,  
show locations of each on sketch.