

**MISSISSIPPI DEPARTMENT OF ENVIRONMENTAL QUALITY**  
Bureau of Land and Water Resources

P. O. Box 10631  
Jackson, MS 39289-0631  
**WATER WELL DRILLERS LOG**

COUNTY WELL LOCATED <b>Lincoln</b>	
WELL NUMBER <b>K 2095</b>	CODED
DATE WELL COMPLETED <b>6/1/94</b>	

PERMIT NUMBER
NAME OF DRILLING FIRM <b>Green Water Well &amp; Supply</b>

NAME & MAILING ADDRESS OF LANDOWNER <b>Keith Case</b>			
<b>770 Auburn Dr. S.W.</b>			
<b>Boque City, MS</b>			
WELL LOCATION:	SEC	TOWNSHIP	RANGE
	<b>8</b>	<b>6 S</b>	<b>6 E</b>
DISTANCE	DIRECTION	NEAREST TOWN	
<b>5</b> Miles	<b>SW</b>	of <b>Brookhaven</b>	
OTHER LANDMARK			
WELL PURPOSE (Home) Irrigation, Municipal, Industrial, Fish Pond, etc.			

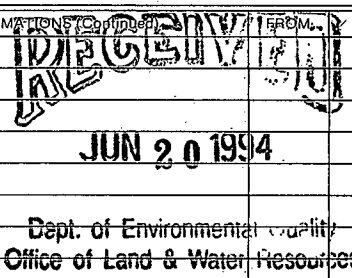
<b>PUMP DATA</b>		
PUMP TYPE (Circle One): <input checked="" type="checkbox"/> Submersible? Turbine Jet Flowing Well, Other (Describe) _____		
POWER TYPE (Circle One): <input checked="" type="checkbox"/> Electric Tractor Diesel Gasoline Butane, Other (Describe) _____ H/P <b>1/2</b>		
Pump Capacity (GPM) <b>10</b>	No. of Stages <b>9</b>	Setting Depth <b>80</b> FT.
PUMP TEST		
Well yielded <b>10</b> GPM with a drawdown of <b>0</b> ft. after <b>1</b> hours of pumping		

<b>WELL DATA</b>		
Well Depth <b>90</b>	Casing Diameter (In.) <b>4 in.</b>	Casing Length (Ft.) <b>80 Ft.</b>
Type of Casing <b>PVC</b>	Hole Depth <b>96</b>	Depth to Static Water Level <b>53</b>
TYPE OF COMPLETION: (Circle One or More): <input checked="" type="checkbox"/> Gravel Packed, Underreamed, Telescoped, Natural Development, Open Hole, Other		
Top of Lap Pipe or Reduction in Casing <b>FEET</b> IF TELESCOPED OR MORE THAN ONE SCREEN: USE BACK PAGE		

<b>LOG DATA</b>	
TYPE OF LOG RUN (Circle One): <input checked="" type="checkbox"/> No Log Run Electric, Gamma Ray, Density, Sonic, Neutron, Other (Describe) _____	
Name of Organization Running Log	

<b>SCREEN DATA</b>		
Diameter - Inches <b>4 in.</b>	Length - Feet <b>10 Ft.</b>	Slot Size - Inches <b>.010</b>
Screen Type <b>PVC</b>	Depth to Bottom - Feet <b>90</b>	

<b>GEOLOGIC DATA (Office Use Only)</b>			
Surface Elev.	Geologic Unit	Unit Thickness	Depth to Top
Subs. SWL	Date	Analysis	Aquifer Test
Driller's Remarks			

DESCRIPTION OF FORMATIONS ENCOUNTERED	FROM	TO	FORMATIONS (Continued) FROM	TO
<b>Red clay</b>	<b>0</b>	<b>17</b>		
<b>Sand &amp; Gravel</b>	<b>17</b>	<b>92</b>		
<b>White Clay</b>	<b>92</b>	<b>96</b>		

IF MORE SPACE IS NEEDED, USE BACK

If well telescopes please sketch and show depths.

GROUND LEVEL

			X

SECTION 8

Please indicate well location X.

ADDITIONAL INFORMATION

If more than one screen,  
show location of each on sketch.