

**MISSISSIPPI DEPARTMENT OF ENVIRONMENTAL QUALITY**  
Bureau of Land and Water Resources

P. O. Box 10631  
Jackson, MS 39289-0631  
**WATER WELL DRILLERS LOG**

COUNTY WELL LOCATED <i>Lincoln</i>	
WELL NUMBER <i>R 2096</i>	CODED
DATE WELL COMPLETED <i>8-31-93</i>	

PERMIT NUMBER
NAME OF DRILLING FIRM <i>Green Water Well &amp; Supply</i>

NAME & MAILING ADDRESS OF LANDOWNER <i>Cecil Watts</i>		
<i>Rt 4 Box 219B</i>		
<i>Bogue Chitto MS.</i>		
WELL LOCATION: SEC	TOWNSHIP	RANGE
<i>19</i>	<i>6</i>	<i>6</i>
	<i>S</i>	<i>W</i>
DISTANCE	DIRECTION	NEAREST TOWN
<i>6</i> Miles	<i>SW</i>	of <i>Brookhaven</i>
OTHER LANDMARK		
WELL PURPOSE <input checked="" type="checkbox"/> Home Irrigation, <input type="checkbox"/> Municipal, <input type="checkbox"/> Industrial, <input type="checkbox"/> Fish Pond, etc.		

<b>PUMP DATA</b>		
PUMP TYPE (Circle One): Submersible, Turbine, Jet, Flowing Well, Other (Describe) _____		
POWER TYPE (Circle One): Electric, Tractor, Diesel, Gasoline, Butane, Other (Describe) _____		
Pump Capacity (GPM)	No. of Stages	Setting Depth
		<i>NO</i> FT.
PUMP TEST		
Well yielded _____ GPM with a drawdown of _____ ft. after _____ hours of pumping		

<b>WELL DATA</b>		
Well Depth <i>33</i>	Casing Diameter (In.) <i>4 in.</i>	Casing Length (Ft.) <i>23</i>
Type of Casing <i>PVC</i>	Hole Depth <i>37</i>	Depth to Static Water Level <i>17</i>
TYPE OF COMPLETION: (Circle One or More): <input checked="" type="checkbox"/> Gravel Packed, <input type="checkbox"/> Underreamed, <input type="checkbox"/> Telescoped, <input type="checkbox"/> Natural Development, <input type="checkbox"/> Open Hole, <input type="checkbox"/> Other (Describe) _____		
Top of Lap Pipe or Reduction in Casing		
FEET	IF TELESCOPED OR MORE THAN ONE SCREEN: USE BACK PAGE	

<b>LOG DATA</b>	
TYPE OF LOG RUN (Circle One): Electric, Gamma Ray, Density, Sonic, Neutron, Other (Describe) _____	
<input checked="" type="checkbox"/> No Log Run.	
Name of Organization Running Log	

<b>SCREEN DATA</b>		
Diameter - Inches <i>4 in.</i>	Length - Feet <i>10 ft.</i>	Slot Size - Inches <i>.010</i>
Screen Type <i>PVC</i>	Depth to Bottom - Feet <i>33</i>	


<b>GEOLOGIC DATA (Office Use Only)</b>			
Surface Elev.	Geologic Unit	Unit Thickness	Depth to Top
Subs. SWL	Date	Analysis	Aquifer Test
Driller's Remarks			

DESCRIPTION OF FORMATIONS ENCOUNTERED	FROM	TO
<i>Red Clay</i>	<i>0</i>	<i>17</i>
<i>Sand</i>	<i>17</i>	<i>32</i>
<i>White Clay</i>	<i>32</i>	<i>37</i>

FORMATIONS (Continued)	FROM	TO
<b>RECEIVED</b>		
<b>JUL 01 1994</b>		
Dept. of Environmental Quality Office of Land & Water Resources		
IF MORE SPACE IS NEEDED, USE BACK		

If well telescopes please  
sketch and show depths.

GROUND LEVEL

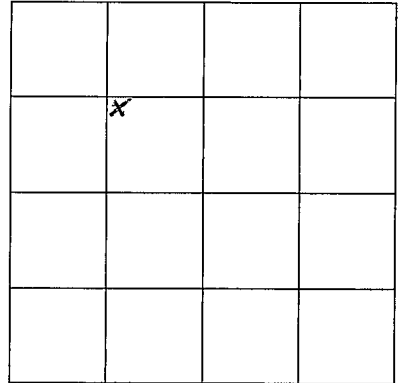

SECTION 19

Please indicate well location X.

ADDITIONAL INFORMATION

If more than one screen,  
show location of each on sketch.