

**MISSISSIPPI DEPARTMENT OF ENVIRONMENTAL QUALITY**  
Bureau of Land and Water Resources

P. O. Box 10631  
Jackson, MS 39289-0631  
**WATER WELL DRILLERS LOG**

COUNTY WELL LOCATED <b>Lincoln</b>	
WELL NUMBER <b>K 2098</b>	CODED
DATE WELL COMPLETED <b>6-30-93</b>	

PERMIT NUMBER
NAME OF DRILLING FIRM <b>Green Water Well &amp; Supply</b>

NAME & MAILING ADDRESS OF LANDOWNER <b>Audrey Smith</b>		
<b>Rt. 5. Box 669</b>		
<b>Brookhaven MS</b>		
WELL LOCATION: SEC	TOWNSHIP	RANGE
<b>28</b>	<b>6</b>	<b>6</b>
	<b>S</b>	<b>W</b>
DISTANCE	DIRECTION	NEAREST TOWN
<b>10</b> Miles	<b>SW</b>	of <b>Brookhaven</b>
OTHER LANDMARK		
WELL PURPOSE: <input checked="" type="checkbox"/> Home Irrigation, Municipal, Industrial, Fish Pond, etc.		

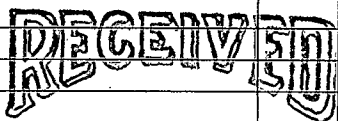
<b>PUMP DATA</b>		
PUMP TYPE (Circle One): Submersible, Turbine, Jet, Flowing Well, Other (Describe) _____		
POWER TYPE (Circle One): Electric, Tractor, Diesel, Gasoline, Butane, Other (Describe) _____ H/P _____		
Pump Capacity (GPM)	No. of Stages	Setting Depth
		<b>FT.</b>
PUMP TEST		
Well yielded _____ GPM with a drawdown of _____ ft. after _____ hours of pumping		

<b>WELL DATA</b>		
Well Depth <b>85</b>	Casing Diameter (In.) <b>4 in.</b>	Casing Length (Ft.) <b>75</b>
Type of Casing <b>PVC</b>	Hole Depth <b>92</b>	Depth to Static Water Level <b>54</b>
TYPE OF COMPLETION: (Circle One or More): <input checked="" type="checkbox"/> Gravel Packed, Underreamed, Telescoped, Natural Development, Open Hole, Other		
Top of Lap Pipe or Reduction in Casing		
<b>FEET</b>		IF TELESCOPED OR MORE THAN ONE SCREEN: USE BACK PAGE

<b>LOG DATA</b>	
TYPE OF LOG RUN (Circle One): Electric, Gamma Ray, Density, Sonic, Neutron, Other (Describe) _____	
Name of Organization Running Log	

<b>SCREEN DATA</b>		
Diameter - Inches <b>4 in.</b>	Length - Feet <b>10 ft.</b>	Slot Size - Inches <b>.010</b>
Screen Type <b>PVC</b>	Depth to Bottom - Feet <b>85</b>	

<b>GEOLOGIC DATA (Office Use Only)</b>			
Surface Elev.	Geologic Unit	Unit Thickness	Depth to Top
Subs. SWL	Date	Analysis	Aquifer Test
Driller's Remarks			

DESCRIPTION OF FORMATIONS ENCOUNTERED	FROM	TO	FORMATIONS (Continued)	FROM	TO
red clay	0	40	 <b>JUL 01 1994</b> Dept. of Environmental Quality Office of Land & Water Resources		
red sand	40	49			
sand	49	85			
Clay	85	92			

IF MORE SPACE IS NEEDED, USE BACK

If well telescopes please  
sketch and show depths.

GROUND LEVEL

	X		

SECTION 28

Please indicate well location X.

ADDITIONAL INFORMATION

If more than one screen,  
show location of each on sketch.