

**MISSISSIPPI DEPARTMENT OF ENVIRONMENTAL QUALITY**

Office of Land and Water Resources

P. O. Box 10631  
Jackson, MS 39289-0631  
**WATER WELL DRILLERS LOG**

COUNTY WELL LOCATED <i>Lincoln</i>	
WELL NUMBER <i>K 2137</i>	CODED
DATE WELL COMPLETED <i>7-31-97</i>	

GREEN Water Well & Supply 1318 Prichard Dr. SE Bogue Chitto, MS 39629
---

NAME & MAILING ADDRESS OF LANDOWNER <i>David Hall</i>			
<i>1928 Hurrican Lake Rd</i>			
<i>Brookhaven ms</i>			
WELL LOCATION: SEC	TOWNSHIP	RANGE	
<i>10</i>	<i>6</i>	<i>N</i>	<i>6</i>
		<i>S</i>	<i>W</i>
DISTANCE	DIRECTION	NEAREST TOWN	
<i>7</i> Miles	<i>West</i>	of <i>Brookhaven</i>	
OTHER LANDMARK			
WELL PURPOSE <input checked="" type="checkbox"/> Home, <input type="checkbox"/> Irrigation, <input type="checkbox"/> Municipal, <input type="checkbox"/> Industrial, <input type="checkbox"/> Fish Pond, etc.			

<b>PUMP DATA</b>		
PUMP TYPE (Circle One): Submersible, Turbine, Jet, Flowing Well, Other (Describe) _____		
POWER TYPE (Circle One): Electric, Tractor, Diesel, Gasoline, Butane, Other (Describe) _____ H/P _____		
Pump Capacity (GPM)	No. of Stages	Setting Depth
		_____ FT.
PUMP TEST		
Well yielded _____ GPM with a drawdown of _____ ft. after _____ hours of pumping		

<b>WELL DATA</b>		
Well Depth <i>75'</i>	Casing Diameter (In.) <i>4"</i>	Casing Length (Ft.) <i>65</i>
Type of Casing <i>PVC</i>	Hole Depth <i>83</i>	Depth to Static Water Level <i>53</i>

<b>LOG DATA</b>	
TYPE OF LOG RUN (Circle One): <input checked="" type="checkbox"/> No Log Run Electric, Gamma Ray, Density, Sonic, Neutron, Other (Describe) _____	
Name of Organization Running Log	

TYPE OF COMPLETION: (Circle One or More): <input checked="" type="checkbox"/> Gravel Packed, <input type="checkbox"/> Underreamed, <input type="checkbox"/> Telescoped, <input type="checkbox"/> Natural Development, <input type="checkbox"/> Open Hole, <input type="checkbox"/> Other (Describe) _____		
--	--	--

WELL GROUTED TO A DEPTH OF <i>10</i> FEET Type Grout (circle one): Cement, Bentonite, or <input checked="" type="checkbox"/> Mix
---

<b>GEOLOGIC DATA (Office Use Only)</b>			
Surface Elev.	Geologic Unit	Unit Thickness	Depth to Top
Subs. SWL	Date	Analysis	Aquifer Test

<b>SCREEN DATA</b>		
Diameter - Inches <i>4 in.</i>	Length - Feet <i>10 ft.</i>	Slot Size - Inches <i>.010</i>
Screen Type <i>PVC</i>	Depth to Bottom - Feet <i>75'</i>	


Driller's Remarks	
Top of Lap Pipe or Reduction in Casing	
FEET <input type="checkbox"/> IF TELESCOPED OR MORE THAN ONE SCREEN: USE BACK PAGE	

DESCRIPTION OF FORMATIONS ENCOUNTERED	FROM	TO
<i>Red Clay</i>	<i>0</i>	<i>12</i>
<i>Clay w/sand streaks</i>	<i>12</i>	<i>58</i>
<i>sand</i>	<i>58</i>	<i>75</i>
<i>White Clay</i>	<i>75</i>	<i>83</i>

FORMATIONS (Continued)	FROM	TO
<b>RECEIVED</b>		
<b>DEC 19 1997</b>		
Dept. of Environmental Quality Office of Land & Water Resources		
IF MORE SPACE IS NEEDED, USE BACK		

If well telescopes please  
sketch and show depths.

GROUND LEVEL

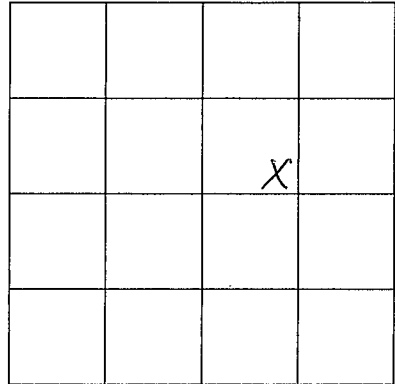

SECTION 10

Please indicate well location X.

ADDITIONAL INFORMATION

If more than one screen,  
show location of each on sketch.