

MISSISSIPPI DEPARTMENT OF ENVIRONMENTAL QUALITY

Office of Land and Water Resources

P. O. Box 10631
Jackson, MS 39289-0631
WATER WELL DRILLERS LOG

COUNTY WELL LOCATED <i>Lincoln</i>	
WELL NUMBER <i>R 2142</i>	CODED
DATE WELL COMPLETED <i>8-17-98</i>	

PERMIT NUMBER <i>Ground Water Well & Supply</i>
1318 Pricedale Dr. SE
NAME OF DRILLING COMPANY <i>Bogue Chino, MS 39629</i>

NAME & MAILING ADDRESS OF LANDOWNER <i>Johnny Rushing</i>			
<i>1074 W. Lincoln Dr. SW</i>			
<i>Brookhaven</i>			
WELL LOCATION:	SEC <i>14</i>	TOWNSHIP <i>6 S</i>	RANGE <i>6 W</i>
DISTANCE <i>1/2</i> Miles	DIRECTION <i>W</i>	NEAREST TOWN <i>West Lincoln</i>	
OTHER LANDMARK			
WELL PURPOSE <input checked="" type="checkbox"/> Home Irrigation, Municipal, Industrial, Fish Pond, etc.			

PUMP DATA		
PUMP TYPE (Circle One): Submersible, Turbine, Jet, Flowing Well, Other (Describe) _____		
POWER TYPE (Circle One): <input checked="" type="checkbox"/> Electric, Tractor, Diesel, Gasoline, Butane, Other (Describe) _____ H/P <i>3/4</i>		
Pump Capacity (GPM) <i>10</i>	No. of Stages <i>12</i>	Setting Depth <i>93'</i> FT.
PUMP TEST		
Well yielded <i>11</i> GPM with a drawdown of <i>10</i> ft. after <i>1</i> hours of pumping		

WELL DATA		
Well Depth <i>95'</i>	Casing Diameter (in.) <i>4"</i>	Casing Length (ft.) <i>85'</i>
Type of Casing <i>PVC</i>	Hole Depth <i>105'</i>	Depth to Static Water Level <i>65'</i>

LOG DATA	
TYPE OF LOG RUN (Circle One): Electric, Gamma Ray, Density, Sonic, Neutron, Other (Describe) _____ <input checked="" type="checkbox"/> No Log Run	
Name of Organization Running Log	

TYPE OF COMPLETION: (Circle One or More): <input checked="" type="checkbox"/> Gravel Packed, Underreamed, Telescoped, Natural Development, Open Hole, Other			
WELL GROUTED TO A DEPTH OF <i>10</i> FEET Type Grout (circle one): Cement, Bentonite, or <input checked="" type="checkbox"/> Mix			

GEOLOGIC DATA (Office Use Only)			
Surface Elev.	Geologic Unit	Unit Thickness	Depth to Top
Subs. SWL	Date	Analysis	Aquifer Test

SCREEN DATA		
Diameter - Inches <i>4"</i>	Length - Feet <i>10'</i>	Slot Size - Inches <i>.010</i>
Screen Type <i>PVC</i>	Depth to Bottom, Feet <i>95'</i>	

Driller's Remarks
Top of Lap Pipe or Reduction in Casing FEET <input type="checkbox"/> IF TELESCOPED OR MORE THAN ONE SCREEN: USE BACK PAGE

DESCRIPTION OF FORMATIONS ENCOUNTERED	FROM	TO	FORMATIONS (Continued)	
			FROM	TO
<i>Red Clay</i>	<i>0</i>	<i>32</i>		
<i>Sand & Gravel</i>	<i>32</i>	<i>98</i>		
<i>White Clay</i>	<i>98</i>	<i>105</i>		


RECEIVED
JAN 25 1999

Dept. of Environmental Quality
Office of Land & Water Resources

IF MORE SPACE IS NEEDED, USE BACK

If well telescopes please sketch and show depths.


GROUND LEVEL

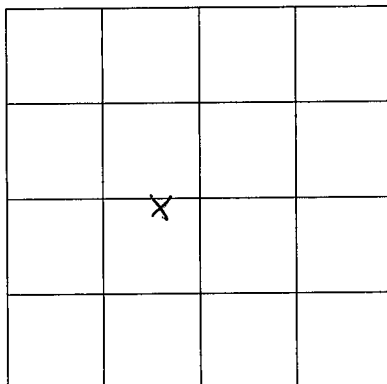

SECTION 14

Please indicate well location X.

ADDITIONAL INFORMATION

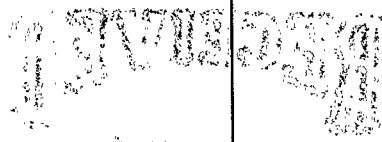

If more than one screen,
show location of each on sketch.