

MISSISSIPPI DEPARTMENT OF ENVIRONMENTAL QUALITY

Office of Land and Water Resources

P. O. Box 10631
Jackson, MS 39289-0631
WATER WELL DRILLERS LOG

COUNTY WELL LOCATED <u>Lincoln</u>	
WELL NUMBER <u>K 2187</u>	CODED
DATE WELL COMPLETED <u>11-19-98</u>	

SPRINT NUMBER	Green Water Well & Supply 1318 Pricedale Dr. SE Bogue Chitto, MS 39629
NAME OF DRILLING FIRM	

NAME & MAILING ADDRESS OF LANDOWNER <u>Steve Hudson</u>			
<u>620 Alvers Ln SW</u>			
<u>Brookhaven</u>			
WELL LOCATION:	SEC	TOWNSHIP	RANGE
	<u>12</u>	<u>6 S</u>	<u>6 E</u>
DISTANCE	DIRECTION	NEAREST TOWN	
<u>6</u> Miles	<u>SW</u>	of <u>Brookhaven</u>	
OTHER LANDMARK			
WELL PURPOSE (Home) Irrigation, Municipal, Industrial, Fish Pond, etc.			

PUMP DATA		
PUMP TYPE (Circle One): <u>Submersible</u> Turbine, Jet, Flowing Well, Other (Describe) _____		
POWER TYPE (Circle One): <u>Electric</u> Tractor, Diesel, Gasoline, Butane, Other (Describe) _____ H/P <u>1/2</u>		
Pump Capacity (GPM)	No. of Stages	Setting Depth
<u>10</u>	<u>9</u>	<u>34</u> FT.
PUMP TEST		
Well yielded <u>10</u> GPM with a drawdown of <u>15</u> ft. after <u>1</u> hours of pumping		

WELL DATA		
Well Depth <u>35'</u>	Casing Diameter (In.) <u>4"</u>	Casing Length (Ft.) <u>25'</u>
Type of Casing <u>PVC</u>	Hole Depth <u>40'</u>	Depth to Static Water Level <u>11'</u>

LOG DATA	
TYPE OF LOG RUN (Circle One): Electric, Gamma Ray, Density, Sonic, Neutron, Other (Describe) _____ <u>No Log Run</u>	
Name of Organization Running Log	

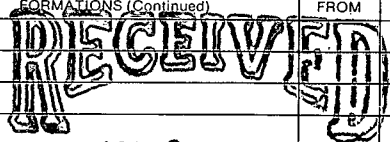
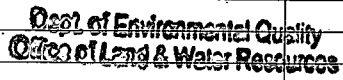
TYPE OF COMPLETION: (Circle One or More):
Gravel Packed Underreamed, Telescoped,
Natural Development, Open Hole, Other

WELL GROUTED TO A DEPTH OF 10 FEET
Type Grout (circle one): Cement, Bentonite, or Mix

GEOLOGIC DATA (Office Use Only)			
Surface Elev.	Geologic Unit	Unit Thickness	Depth to Top
Subs. SWL	Date	Analysis	Aquifer Test
Driller's Remarks			
Top of Lap Pipe or Reduction in Casing			
FEET		IF TELESCOPED OR MORE THAN ONE SCREEN: USE BACK PAGE	

SCREEN DATA		
Diameter - Inches <u>4"</u>	Length - Feet <u>10'</u>	Slot Size - Inches <u>.010</u>
Screen Type <u>PVC</u>	Depth to Bottom - Feet <u>35'</u>	

DESCRIPTION OF FORMATIONS ENCOUNTERED	FROM	TO
Red Clay	0	4
White Clay	4	10
Sand/Gravel	10	35
Yellow Clay	35	40

FORMATIONS (Continued)	FROM	TO
 JAN 25 1999		
		
IF MORE SPACE IS NEEDED, USE BACK		

If well telescopes please sketch and show depths.

GROUND LEVEL

		X	

SECTION 12

Please indicate well location X.

ADDITIONAL INFORMATION

[Faint, illegible text]

[Faint, illegible text]

If more than one screen, show location of each on sketch.