

MISSISSIPPI DEPARTMENT OF ENVIRONMENTAL QUALITY
Office of Land and Water Resources

P. O. Box 10631
Jackson, MS 39289-0631
WATER WELL DRILLERS LOG

COUNTY WELL LOCATED <i>Lincoln</i>	
WELL NUMBER K 2165	CODED
DATE WELL COMPLETED <i>6/1/01</i>	

PERMIT NUMBER Green Water Well & Supply
NAME OF DRILLER 1318 Pricedale Dr. SE
Bogue Chitto, MS 39629

NAME & MAILING ADDRESS OF LANDOWNER <i>Scotty Lavid</i>		
<i>416 Jackson Liberty</i>		
<i>Brookhaven</i>		
WELL LOCATION: SEC	TOWNSHIP	RANGE
<i>12</i>	<i>6</i>	<i>(N) 6 (E)</i>
DISTANCE	DIRECTION	NEAREST TOWN
<i>5</i> Miles	<i>SW</i>	of <i>Brookhaven</i>
OTHER LANDMARK		
WELL PURPOSE: <i>(O)</i> Home Irrigation, Municipal, Industrial, Fish Pond, etc.		

PUMP DATA		
PUMP TYPE (Circle One): Submersible, Turbine, Jet, Flowing Well, Other (Describe) _____		
POWER TYPE (Circle One): Electric, Tractor, Diesel, Gasoline, Butane, Other (Describe) _____ H/P <i>1</i>		
Pump Capacity (GPM) <i>16</i>	No. of Stages <i>10</i>	Setting Depth <i>140</i> FT.
PUMP TEST		
Well yielded <i>15</i> GPM with a drawdown of <i>0</i> ft. after <i>1</i> hours of pumping		

WELL DATA		
Well Depth <i>190</i>	Casing Diameter (In.) <i>4</i>	Casing Length (Ft.) <i>180'</i>
Type of Casing <i>PVC</i>	Hole Depth <i>200'</i>	Depth to Static Water Level <i>100</i>

LOG DATA	
TYPE OF LOG RUN (Circle One): <i>(No Log Run)</i> Electric, Gamma Ray, Density, Sonic, Neutron, Other (Describe) _____	
Name of Organization Running Log	

TYPE OF COMPLETION: (Circle One or More):
Gravel Packed, Underreamed, Telescoped,
Natural Development, Open Hole, Other
(Describe) _____

WELL GROUTED TO A DEPTH OF *10* FEET
Type Grout (circle one): Cement, Bentonite, or *(M)*

GEOLOGIC DATA (Office Use Only)			
Surface Elev.	Geologic Unit	Unit Thickness	Depth to Top
Subs. SWL	Date	Analysis	Aquifer Test

SCREEN DATA		
Diameter - Inches <i>4</i>	Length - Feet <i>10'</i>	Slot Size - Inches <i>.010</i>
Screen Type <i>PVC</i>	Depth to Bottom - Feet <i>190</i>	

Driller's Remarks	
Top of Lap Pipe or Reduction in Casing	
FEET	IF TELESCOPED OR MORE THAN ONE SCREEN: USE BACK PAGE


DESCRIPTION OF FORMATIONS ENCOUNTERED	FROM	TO
<i>Red Clay</i>	<i>0</i>	<i>20</i>
<i>Streaky</i>	<i>20</i>	<i>43</i>
<i>Sand & Gravel</i>	<i>43</i>	<i>88</i>
<i>White Clay</i>	<i>88</i>	<i>105</i>
<i>Blue Clay</i>	<i>105</i>	<i>120</i>
<i>Sand</i>	<i>120</i>	<i>200</i>

FORMATIONS (Continued)	FROM	TO

REC'D JUN 13 2001

If well telescopes please sketch and show depths.

GROUND LEVEL

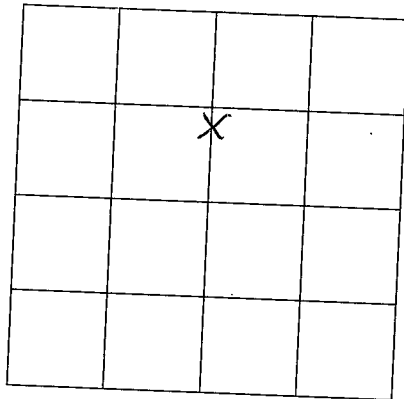

SECTION 12

Please indicate well location X.

ADDITIONAL INFORMATION

If more than one screen,
show location of each on sketch.