

MISSISSIPPI DEPARTMENT OF ENVIRONMENTAL QUALITY
Office of Land and Water Resources

P. O. Box 10631
Jackson, MS 39289-0631
WATER WELL DRILLERS LOG

COUNTY WELL LOCATED
Lincoln

WELL NUMBER CODED
3A512

K-2170

DATE WELL COMPLETED
7-12-00

PERMIT NUMBER
510

NAME OF DRILLING FIRM
Easley Waterwell

B'hamen MS 39601

NAME & MAILING ADDRESS OF LANDOWNER
Mrs. Nettles

1333 Hickoey Ln

Bogue Chitto MS 39629

WELL LOCATION: SEC TOWNSHIP RANGE
25 6 N 6 W

DISTANCE DIRECTION NEAREST TOWN
Miles of

OTHER LANDMARK

WELL PURPOSE: Home Irrigation, Municipal, Industrial, Fish Pond, etc.

PUMP DATA

PUMP TYPE (Circle One):
 Submersible, Turbine, Jet, Flowing Well,
Other (Describe) _____

POWER TYPE (Circle One):
 Electric, Tractor, Diesel, Gasoline, Butane,
Other (Describe) _____ H/P _____

Pump Capacity (GPM) No. of Stages Setting Depth FT.

PUMP TEST

Well yielded _____ GPM with
a drawdown of _____ ft.
after _____ hours of pumping

WELL DATA

Well Depth Casing Diameter (In.) Casing Length (Ft.)
140' 4" 120'

Type of Casing Hole Depth Depth to Static Water Level
PVC

LOG DATA

TYPE OF LOG RUN (Circle One): No Log Run, Electric, Gamma Ray, Density, Sonic, Neutron, Other (Describe) _____

Name of Organization Running Log

TYPE OF COMPLETION: (Circle One or More):
Gravel Packed, Underreamed, Telescoped, Natural Development, Open Hole, Other (Describe) _____

GEOLOGIC DATA (Office Use Only)

Surface Elev.	Geologic Unit	Unit Thickness	Depth to Top
Subs. SWL	Date	Analysis	Aquifer Test

WELL GROUTED TO A DEPTH OF 10 FEET
Type Grout (circle one) Cement, Bentonite, or Mix

SCREEN DATA

Diameter - inches	Length - Feet	Slot Size - inches
<u>4"</u>	<u>20'</u>	<u>0.10</u>
Screen Type	Depth to Bottom - Feet	
<u>PVC</u>		

Driller's Remarks

Top of Lap Pipe or Reduction in Casing


FEET IF TELESCOPED OR MORE THAN ONE SCREEN: USE BACK PAGE

DESCRIPTION OF FORMATIONS ENCOUNTERED	FROM	TO	FORMATIONS (Continued)	
			FROM	TO
<u>Clay</u>	<u>0</u>	<u>20</u>		
<u>Sand</u>	<u>20</u>	<u>30</u>		
<u>Clay</u>	<u>30</u>	<u>120</u>		
<u>SAND</u>	<u>120</u>	<u>140</u>		

REC'D JUN 13 2001

If well telescopes please
sketch and show depths.

GROUND LEVEL

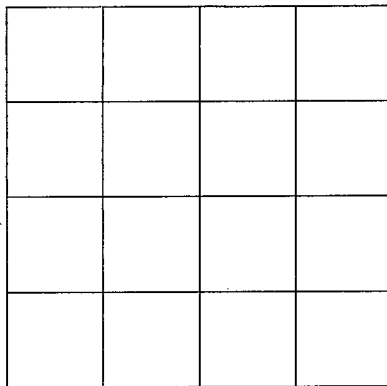

SECTION _____

Please indicate well location X.

ADDITIONAL INFORMATION

If more than one screen,
show location of each on sketch.