

**MISSISSIPPI DEPARTMENT OF ENVIRONMENTAL QUALITY**  
**Office of Land and Water Resources**

P. O. Box 10631  
 Jackson, MS 39289-0631

**WATER WELL DRILLERS LOG**

COUNTY WELL LOCATED <u>Lincoln</u>	
WELL NUMBER <u>319534</u>	CODED
<u>K-2172</u>	
DATE WELL COMPLETED <u>9-25-00</u>	

PERMIT NUMBER <u>510</u>
NAME OF DRILLING FIRM <u>Easley Waterwell</u>
<u>B'haven MS 39601</u>

NAME & MAILING ADDRESS OF LANDOWNER <u>Peggie Mrs Allen</u>			
<u>346 new hope trail 39601</u>			
<u>McCall Creek MS 39647</u>			
WELL LOCATION: SEC	TOWNSHIP	RANGE	
<u>29</u>	<u>6</u>	<u>N</u>	<u>6</u>
DISTANCE _____ Miles		DIRECTION <u>S</u> of <u>W</u> NEAREST TOWN _____	
OTHER LANDMARK _____			
WELL PURPOSE: <input checked="" type="radio"/> Home Irrigation, <input type="radio"/> Municipal, <input type="radio"/> Industrial, <input type="radio"/> Fish Pond, etc.			

<b>PUMP DATA</b>		
PUMP TYPE (Circle One): Submersible, Turbine, Jet, Flowing Well, Other (Describe) _____		
POWER TYPE (Circle One): <input checked="" type="radio"/> Electric, <input type="radio"/> Tractor, <input type="radio"/> Diesel, <input type="radio"/> Gasoline, <input type="radio"/> Butane, Other (Describe) _____ H/P _____		
Pump Capacity (GPM)	No. of Stages	Setting Depth _____ FT.
PUMP TEST		
Well yielded _____ GPM with a drawdown of _____ ft. after _____ hours of pumping		

<b>WELL DATA</b>		
Well Depth <u>80</u>	Casing Diameter (In.) <u>4"</u>	Casing Length (Ft.) <u>60</u>
Type of Casing <u>PVC</u>	Hole Depth	Depth to Static Water Level
TYPE OF COMPLETION: (Circle One or More): <input checked="" type="checkbox"/> Gravel Packed, <input type="checkbox"/> Underreamed, <input type="checkbox"/> Telescoped, <input type="checkbox"/> Natural Development, <input type="checkbox"/> Open Hole, <input type="checkbox"/> Other (Describe) _____		

<b>LOG DATA</b>	
TYPE OF LOG RUN (Circle One): <input type="radio"/> No Log Run, <input type="radio"/> Electric, <input type="radio"/> Gamma Ray, <input type="radio"/> Density, <input type="radio"/> Sonic, <input type="radio"/> Neutron, Other (Describe) _____	
Name of Organization Running Log _____	

WELL GROUTED TO A DEPTH OF <u>10</u> FEET
Type Grout (circle one): <input checked="" type="radio"/> Cement, <input type="radio"/> Bentonite, or Mix

<b>GEOLOGIC DATA (Office Use Only)</b>			
Surface Elev.	Geologic Unit	Unit Thickness	Depth to Top
Subs. SWL	Date	Analysis	Aquifer Test

<b>SCREEN DATA</b>		
Diameter - Inches <u>4"</u>	Length - Feet <u>20'</u>	Slot Size - Inches
Screen Type <u>PVC</u>	Depth to Bottom - Feet <u>0-12</u>	

Driller's Remarks	
Top of Lap Pipe or Reduction in Casing	
<b>FEET</b>	
IF TELESCOPED OR MORE THAN ONE SCREEN: USE BACK PAGE	


DESCRIPTION OF FORMATIONS ENCOUNTERED	FROM	TO
<u>Chalk</u>	<u>0</u>	<u>10</u>
<u>Clay</u>	<u>10</u>	<u>80</u>

FORMATIONS (Continued)	FROM	TO

**REC'D JUN 13 2001**

If well telescopes please  
sketch and show depths.

GROUND LEVEL

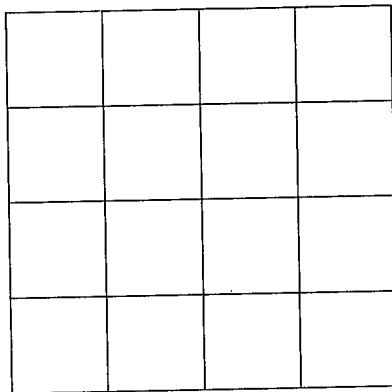

SECTION \_\_\_\_\_

Please indicate well location X.

ADDITIONAL INFORMATION

If more than one screen,  
show location of each on sketch.