

MISSISSIPPI DEPARTMENT OF ENVIRONMENTAL QUALITY

Office of Land and Water Resources

P. O. Box 10631
Jackson, MS 39289-0631
WATER WELL DRILLERS LOG

COUNTY WELL LOCATED LINCOLN	
WELL NUMBER K-2124	CODED
DATE WELL COMPLETED 3-9-00	

PERMIT NUMBER 0-287
NAME OF DRILLING FIRM REEVES WELL SER.

NAME & MAILING ADDRESS OF LANDOWNER SANDY LOFTON WEST LINCOLN			
WELL LOCATION: SEC 33 TOWNSHIP 6 RANGE 6			
DISTANCE 8 Miles DIRECTION NW of NEAREST TOWN SUMMIT			
OTHER LANDMARK			
WELL PURPOSE: <u>Home</u> , Irrigation, Municipal, Industrial, Fish Pond, etc.			

PUMP DATA		
PUMP TYPE (Circle One): Submersible, Turbine, Jet, Flowing Well, Other (Describe) _____		
POWER TYPE (Circle One): Electric, Tractor, Diesel, Gasoline, Butane, Other (Describe) _____ H/P _____		
Pump Capacity (GPM)	No. of Stages	Setting Depth FT.
PUMP TEST		
Well yielded 40 GPM with a drawdown of 0 ft. after 1 hours of pumping		

WELL DATA		
Well Depth 70'	Casing Diameter (In.) 4"	Casing Length (Ft.) 20'
Type of Casing PVC	Hole Depth 70'	Depth to Static Water Level 40'
TYPE OF COMPLETION: (Circle One or More): Gravel Packed, Underreamed, Telescoped, Natural Development, Open Hole, Other (Describe) LOGAL. SAND		
WELL GROUTED TO A DEPTH OF 10 FEET Type Grout (circle one): <u>Cement</u> , Bentonite, or Mix		

LOG DATA	
TYPE OF LOG RUN (Circle One): No Log Run, Electric, Gamma Ray, Density, Sonic, Neutron, Other (Describe) _____	
Name of Organization Running Log	

SCREEN DATA		
Diameter - Inches 4"	Length - Feet 10'	Slot Size - Inches 10 SLOT
Screen Type PVC	Depth to Bottom - Feet 70'	


GEOLOGIC DATA (Office Use Only)			
Surface Elev.	Geologic Unit	Unit Thickness	Depth to Top
Subs. SWL	Date	Analysis	Aquifer Test
Driller's Remarks			
Top of Lap Pipe or Reduction in Casing			
FEET		IF TELESCOPED OR MORE THAN ONE SCREEN: USE BACK PAGE	

DESCRIPTION OF FORMATIONS ENCOUNTERED	FROM	TO	FORMATIONS (Continued)	
			FROM	TO
CLAY	0	10	RECEIVED	
SAND	10	50	FEB 17 2002	
SAND & GRAVEL	50	70	BY: OLWR	

IF MORE SPACE IS NEEDED, USE BACK

If well telescopes please sketch and show depths.

GROUND LEVEL

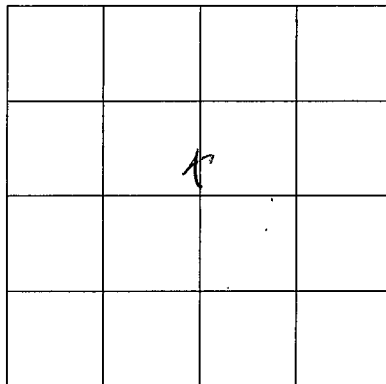

SECTION

22

Please indicate well location X.

ADDITIONAL INFORMATION

If more than one screen,
show location of each on sketch.