

Lincoln
L
5/25/77

MISSISSIPPI
BOARD OF WATER COMMISSIONERS
416 North State Street
130 Jackson, Mississippi 39201

WATER WELL DRILLERS LOG

MAY 25 19 77 COVINGTON Lincoln
date well completed firm name county well located

LANDOWNER: Dewey Lofton
Bono Childs
(mailing address)

description of fomations encountered	from	to
CLAY	0	14
SANDY CLAY	14	35
CLAY	35	42
SAND	42	58

WELL LOCATION:
sec. 33 T. 6 N R. 7 E
2 1/2 miles West of Booneville
(distance) (direction) (nearest town)

WELL PURPOSE: Home
(home, irrigation, municipal, industrial)

- WELL COMPLETION DATA:
- (1) diameter (inches) 4
 - (2) total depth (feet) 58
 - (3) static water level (feet) 42 below top of ground
 - (4) casing PHASZC 51 (material) (depth)
4 (size) if telescope see back.
 - (5) screen 7 51 (length) (depth to top)
4 PHASZC (size) (material)
 - (6) pump 1/2 5 (HP) (yield gpm)
(type power)
 - (7) electric log (yes or no)
 - (organization running log)
 - (8) how well bottom plugged Wood


DRILLERS REMARKS:

RECEIVED
JUN 20 1977

MISS. BOARD OF WATER COMMISSIONERS

If well telescopes please sketch and show depths.

GROUND LEVEL

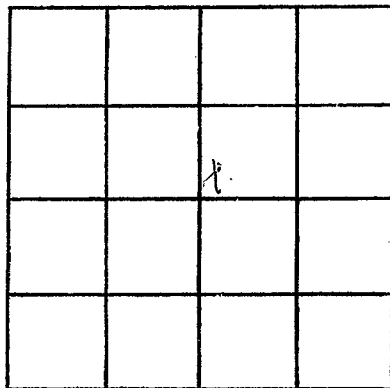

SECTION 33

Please indicate well location X.

ADDITIONAL INFORMATION

If more than one screen,
show locations of each on sketch.