

LINCOLN

MISSISSIPPI BOARD OF WATER COMMISSIONERS

L1

3-31-65 CODED

WATER WELL DRILLERS LOG

Date: 3-31, 1965, Driller: Chester Reeves County: Lincoln
(Name)

(1) Owner of Land: George Turner
(Name)
RFD, Bogueschitta
(Address)

(2) Location: 9 6²⁵ R2E
8 miles NW of Bogueschitta
(distance) (direction) (Nearest Town)

(3) Topography: Hilly
(Hilly) (Flat) (Level)

(4) Purpose of Well: Domestic
(Domestic Irrigation
Municipal, Industrial, Other)

Description & Color of Materials Sand, Clay, Red Clay, Shell, etc.	Thick- ness Feet	Depth Feet
<u>yellow surface clay</u>	<u>15</u>	<u>15</u>
<u>sand & gravel</u>	<u>33</u>	<u>48</u>
<u>blue white & yellow chalk</u>	<u>82</u>	<u>130</u>
<u>white sand</u>	<u>13</u>	<u>143</u>

Information upon completion of well:

(1) Diameter 4 inches.

(2) Total Depth 143 feet.

(3) Water Level 65 feet below top of ground.

(4) Cased to bottom (Size 4")

(5) Screen: Size 4", Length 7'


(6) Were any formations sealed against pollution?
 yes, no.

CODED

If YES depth of formation _____

Why _____

Drillers Remarks: old well
ball

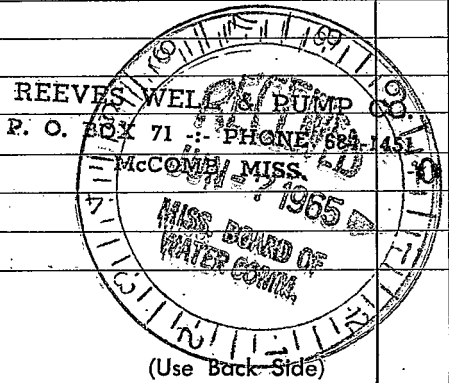

Well No.

(Use Back Side)

