

**MISSISSIPPI
BOARD OF WATER COMMISSIONERS
416 North State Street
Jackson, Mississippi 39201**

WATER WELL DRILLERS LOG

Lincoln
L4
10-67 CODED

10-18 date well completed 69 Fitzgerald Water Well Service Lincoln firm name Lincoln county well located

LANDOWNER: J.H. Kern
24 Brookhaven

(mailing address)

WELL LOCATION:
sec. 5 T 6 N 7 R 7 E
6 miles SW of Brookhaven
(distance) (direction) (nearest town)

WELL PURPOSE: house
(home, irrigation, municipal, industrial)

WELL COMPLETION DATA:

(1) diameter (inches) 4

(2) total depth (feet) 193

(3) static water level (feet) 90 below above top of ground.

(4) casing plastic 187
(material) (depth)
4 if telescope see back.
(size)


(5) screen 4' 187
(length) (depth to top)
4 plastic
(size) (material)

(6) pump — —
(HP) (yield gpm)
3/4 c
(type power)

(7) electric log NO
(yes or no)
—
(organization running log)

(8) how well bottom plugged Weld plug


description of formations encountered	from	to
<u>top soil / clay</u>	<u>0</u>	<u>15</u>
<u>Red sand</u>	<u>15</u>	<u>25</u>
<u>Heavy gravel</u>	<u>25</u>	<u>52</u>
<u>White Chalk</u>	<u>52</u>	<u>64</u>
<u>Blue Chalk</u>	<u>64</u>	<u>155</u>
—————		
—————		
<u>fine sand</u>	<u>155</u>	<u>180</u>
<u>Coarse sandy gravel</u>	<u>180</u>	<u>193</u>
<u>Chalk</u>	<u>193</u>	

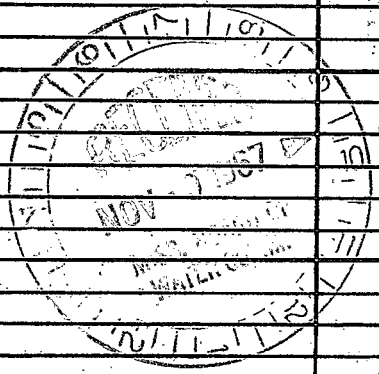

DRILLERS REMARKS: —

If well telescopes please sketch and show depths.

GROUND LEVEL

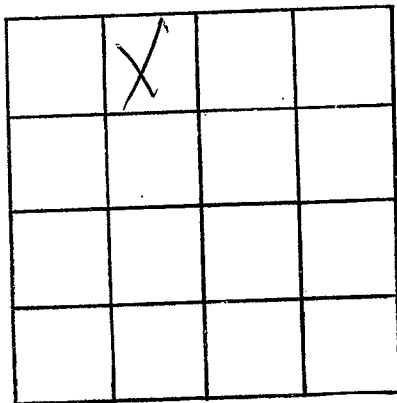

SECTION 5

Please indicate well location X.

ADDITIONAL INFORMATION

If more than one screen,
show locations of each on sketch.