

OK'd
10/17/61

Q-26

5-10-61

CODED

WATER WELL DRILLERS LOG

Date: 5-10, 1961, Driller: Chester Keener County: Pike

(Name)

(1) Owner of Land: RALPH Felder
(Name)
RFD Summit
(Address)

Description & Color of Materials Sand, Clay, Red Clay, Shell, etc.	Thick- ness Feet	Depth Feet
Well Clay	12	12
Red Sand & Gravel	38	50
Finest white sand	23	73
Red Gravel	8	81

(2) Location: 1/4, 1/4, Sec 36 T6 R 7
10 miles N.E. of Summit
(distance) (direction) (Nearest Town)

(3) Topography: Hilly
(Hilly) (Flat) (Level)

(4) Purpose of Well: Domestic
(Domestic Irrigation
Municipal, Industrial, Other)

Information upon completion of well:


- (1) Diameter: 2 inches.
- (2) Total Depth: 81 feet.
- (3) Water Level: 36 feet below top of ground.
- (4) Cased to: bottom Size
- (5) Screen: Size 1/4", Length 6'
- (6) Were any formations sealed against pollution?
yes, no.

Cannot locate

CODED

If YES depth of formation
Why

Drillers Remarks: Had to set
2" well-went bad-

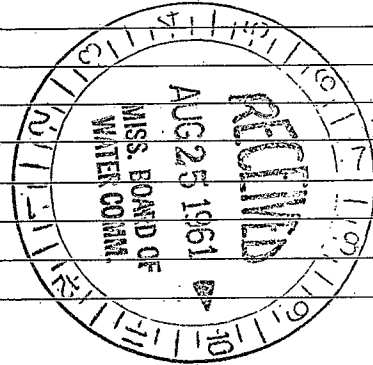

(Use Back Side)

Well No.

