

MISSISSIPPI  
BOARD OF WATER COMMISSIONERS  
416 North State Street  
Jackson, Mississippi 39201

**CODED**

WATER WELL DRILLERS LOG

Lincoln  
L-10  
7-28-71

28 July 1971 J.H. Waterwell Lincoln

LANDOWNER:

George May  
Bogus Chitto  
(mailing address)

description of formations encountered

from to

clay	0	25
clay	25	35
3rd shell	35	60
sand	60	70
2nd shell	70	110

WELL LOCATION:

sec 31 T 6N R 4E  
4 6N 7E Bogus Chitto  
(distance) miles (direction) (nearest town)

WELL PURPOSE:

(home, irrigation, municipal, industrial)

WELL COMPLETION DATA:

- (1) diameter (inches) 4
- (2) total depth (feet) 110
- (3) static water level (feet) 65 below above top of ground.
- (4) casing (material) (PI) (depth) 104
- (size) If telescope see back.
- (5) screen (length) 6 (depth to top) 104
- (size) (material) 4 (PI)
- (6) pump (HP) (yield gpm) 1/2 8
- (type power) Electric
- (7) electric log (yes or no)

**CODED**

(organization running log)

(8) how well bottom plugged wood


SEP 10 1971

DRILLERS REMARKS:

MISS. BD. OF  
WATER COMMISSIONERS

If well telescopes please sketch and show depths.

GROUND LEVEL

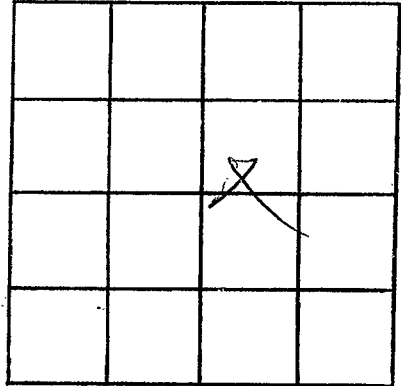

SECTION 31

Please indicate well location X.

ADDITIONAL INFORMATION

If more than one screen,  
show locations of each on sketch.