

LINCOLN
LII
10-18-71

MISSISSIPPI
 BOARD OF WATER COMMISSIONERS
 416 North State Street
 Jackson, Mississippi 39201

CODED

WATER WELL DRILLERS LOG

10-18 date well completed 19 71 *Fitzgerald* firm name Lincoln county well located

LANDOWNER:	description of formations encountered	from	to
<i>T E Barby</i>	<i>Red Clay</i>	<i>6</i>	<i>20</i>
<i>R.R. Bogue Editta</i> (mailing address)	<i>Blue Clay Red White</i>	<i>2</i>	<i>156</i>
WELL LOCATION:			
sec. <i>25T</i> <i>6N</i> R. <i>7E</i>			
<i>1</i> miles <i>N</i> of <i>Bogue Editta</i> (distance) (direction) (nearest town)			
WELL PURPOSE: <i>Home</i> (home, irrigation, municipal, industrial)			
WELL COMPLETION DATA:			
(1) diameter (inches) <i>4</i>			
(2) total depth (feet) <i>165</i>			
(3) static water level (feet) <i>40</i> below above top of ground.			
(4) casing <i>Plast</i> , <i>157</i> , (material) (depth)			
<i>4</i> (size) if telescope see back.			
(5) screen <i>8</i> , <i>157</i> (length) (depth to top)			
<i>4</i> , <i>Plaster</i> (size) (material)			
(6) pump <i>1/2</i> , <i>12</i> (HP) (yield gpm)			
<i>Colu</i> (type power)			
(7) electric log <i>no</i> (yes or no)			
(organization running log)			
(8) how well bottom plugged <i>wood plug</i>			
DRILLERS REMARKS:			


CODED

OCT 28 1971

MISS. DIV. OF
 WATER CONTROL

If well telescopes please sketch and show depths.

GROUND LEVEL

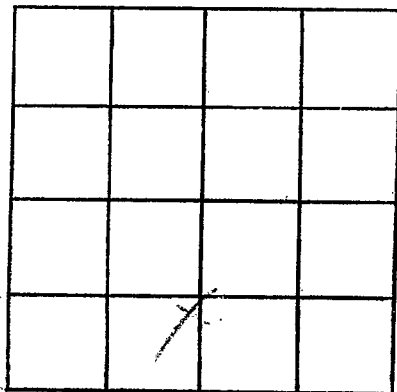

SECTION 25

Please indicate well location X.

ADDITIONAL INFORMATION

If more than one screen,
show locations of each on sketch.