

Lincoln  
L 12  
2-24-72

MISSISSIPPI  
 BOARD OF WATER COMMISSIONERS  
 416 North State Street  
 Jackson, Mississippi 39201

**CODED**

**WATER WELL DRILLERS LOG**

Feb. 24 19 72 Grenn Water Well Contractor Lincoln  
 date well completed firm name county well located

LANDOWNER: James O. Crosby Bogue Chitto, Miss.	description of formations encountered	from	to
	red sand & clay	0	70
	clay	70	80
(mailing address)			
<b>WELL LOCATION:</b>			
sec. <u>27</u> T <u>6</u> N R <u>7</u> E S- W			
<u>5</u> miles S of Brookhaven			
(distance) (direction) (nearest town)			
<b>WELL PURPOSE:</b> home (home, irrigation, municipal, industrial)			
<b>WELL COMPLETION DATA:</b>			
(1) diameter (inches) <u>6</u>			
(2) total depth (feet) <u>80</u>			
(3) static water level (feet) <u>45</u> below above top of ground.			
(4) casing <u>PVC</u> <u>64</u> (material) (depth)			
<u>4"</u> (size) if telescope see back.			
(5) screen <u>6'</u> <u>64</u> (length) (depth to top)			
<u>.010</u> <u>PVC</u> (size) (material)			
(6) pump <u>did not install</u> (HP) (yield gpm)			
(type power)			
(7) electric log <u>no</u> (yes or no)			
(organization running log)			
(8) how well bottom plugged <u>wood</u>			
<b>DRILLERS REMARKS:</b>			


**CODED**

APR 25 1972

MISS. Bd. of  
 WATER COMMISSIONERS

If well telescopes please sketch and show depths.

GROUND LEVEL

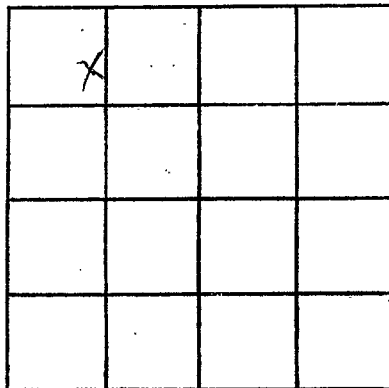

SECTION 27

Please indicate well location X.

ADDITIONAL INFORMATION

If more than one screen,  
show locations of each on sketch.