

**LINCOLN**  
**L13**  
**3-16-72**

MISSISSIPPI  
 BOARD OF WATER COMMISSIONERS  
 416 North State Street  
 Jackson, Mississippi 39201  
**WATER WELL DRILLERS LOG**

**CODED**

March 16 1972 Grenn Water Well Contractor Linnaln  
 date well completed firm name county well located

LANDOWNER: Aubrey Wallace  
 Route 4,  
 Bogue Chitto, Miss.  
 (mailing address)

description of formations encountered	from	to
sand, clay and gravel	0	97
clay	97	120

WELL LOCATION:  
 sec. 36 T 6 N R 7 E  
 10 miles S of Brookhaven  
 (distance) (direction) (nearest town)

WELL PURPOSE: home  
 (home, irrigation, municipal, industrial)

- WELL COMPLETION DATA:
- (1) diameter (inches) 6
  - (2) total depth (feet) 120
  - (3) static water level (feet) 75 below top of ground.
  - (4) casing PVC 90  
 (material) (depth)  
 4" If telescope see back.  
 (size)
  - (5) screen 6' 90  
 (length) (depth to top)  
 .010 PVC  
 (size) (material)
  - (6) pump 1/3 Sub 7  
 (HP) (yield gpm)  
 electric  
 (type power)
  - (7) electric log no  
 (yes or no)
- (organization running log)
- (8) how well bottom plugged wood

**CODED**


APR 25 1972

DRILLERS REMARKS:

MISS. DEP. OF  
 AGRICULTURE  
 JACKSON, MISSISSIPPI

If well telescopes please sketch and show depths.

GROUND LEVEL

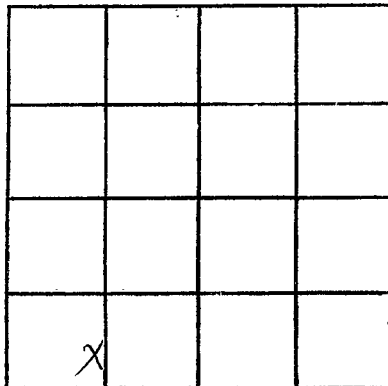

SECTION 36

Please indicate well location X.

ADDITIONAL INFORMATION

If more than one screen,  
show locations of each on sketch.