

LINCOLN
L 14
10-19-73

MISSISSIPPI
BOARD OF WATER COMMISSIONERS
416 North State Street
Jackson, Mississippi 39201

CODED

WATER WELL DRILLERS LOG

Oct. 19 1973 Green Water Well Co. Lincoln
date well completed firm name county well located

LANDOWNER: Robert Hutcherson
Rt 4, Box 32
Bogue Chitto Miss.
(mailing address)

description of formations encountered
Citronelle
from 0 to 100

WELL LOCATION:
sec 28 T. 6 N. R. 7 E
4 miles NW of Bogue Chitto
(distance) (direction) (nearest town)

WELL PURPOSE: home
(home, irrigation, municipal, industrial)

- WELL COMPLETION DATA:
- (1) diameter (inches) 6"
 - (2) total depth (feet) 80
 - (3) static water level (feet) 65 below top of ground.
 - (4) casing PVC, 74 (material) (depth)
4" (size) if telescope see back.
 - (5) screen 6' 74 (length) (depth to top)
010 PVC (size) (material)
 - (6) pump did not install (HP) (yield gpm)
(type power)
 - (7) electric log no. (yes or no)
(organization running log)
 - (8) how well bottom plugged wood

CODED


NOV 25 1973

DRILLERS REMARKS:

MISS. DIV. OF
WATER RESOURCES

If well telescopes please sketch and show depths.

GROUND LEVEL

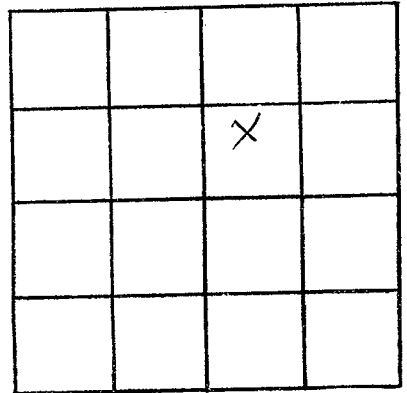

SECTION 28

Please indicate well location X.

ADDITIONAL INFORMATION

If more than one screen, show locations of each on sketch.