

LINCOLN
L15
2-13-74

MISSISSIPPI
BOARD OF WATER COMMISSIONERS
416 North State Street
Jackson, Mississippi 39201

CODED

WATER WELL DRILLERS LOG

Feb. 13 19 74 Green Well Co. Lincoln
date well completed firm name county well located

LANDOWNER:

Carl Hollingsworth
Brookhaven Miss
(mailing address)

description of formations encountered

from

to

Catronelle

0

65

WELL LOCATION:

sec. 29 6 N. R. 7 E
5 W
12 miles SW of Brookhaven
(distance) (direction) (nearest town)

CODED


WELL PURPOSE:

Home
(home, irrigation, municipal, industrial)

WELL COMPLETION DATA:

- (1) diameter (inches) 6"
- (2) total depth (feet) 65
- (3) static water level (feet) 50 below
top of ground. above
- (4) casing PVC, 44'
(material) (depth)
4" if telescope see back.
(size)
- (5) screen 6', 44'
(length) (depth to top)
.010, PVC
(size) (material)
- (6) pump did not install
(HP) (yield gpm)
- (type power)
- (7) electric log no
(yes or no)
- (organization running log)
- (8) how well bottom plugged Wood

DRILLERS REMARKS:

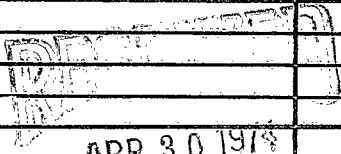

APR 30 1974

MISS. BD. OF WATER

If well telescopes please sketch and show depths.

GROUND LEVEL

	X		

SECTION 20

Please indicate well location X.

ADDITIONAL INFORMATION

If more than one screen, show locations of each on sketch.