

LINCOLN
L 16
5-19-74

MISSISSIPPI
BOARD OF WATER COMMISSIONERS
416 North State Street
Jackson, Mississippi 39201

CODED

74 WATER WELL DRILLERS LOG

May 19 1973 *Charter Keenes Lincoln*
date well completed firm name county well located

LANDOWNER *Charli Cook*
Rt 4, Bogues chitto

description of formations encountered from to

(mailing address)

WELL LOCATION:

sec 30 T 6 N R 7 E
5 1/2 miles W of Wauwages chitto
(distance) (direction) (nearest town)

Clay 0 19
Red shaly sand 19 68
Small gravel & sand 68 73

WELL PURPOSE: Home
(home, irrigation, municipal, industrial)

WELL COMPLETION DATA:

- (1) diameter (inches) 4"
- (2) total depth (feet) 73
- (3) static water level (feet) 40 below top of ground.
- (4) casing Plast bathm
(material) (depth)
- _____ If telescope see back.
(size)
- (5) screen 6' 67'
(length) (depth to top)
- 4" Plast
(size) (material)
- (6) pump 1/2 HP 7
(HP) (yield gpm)
- elect
(type power)
- (7) electric log NO
(yes or no)
- _____ (organization running log)

CODED

(8) how well bottom plugged Wooden plug


DRILLERS REMARKS: New house

REGISTERED

MAY 24 1974

If well telescopes please sketch and show depths.

GROUND LEVEL

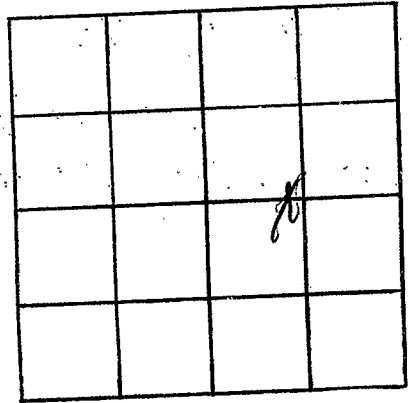

SECTION 30

Please indicate well location X.

ADDITIONAL INFORMATION

If more than one screen, show locations of each on sketch.