

LINCOLN  
L 17  
7-3-73

MISSISSIPPI  
BOARD OF WATER COMMISSIONERS  
416 North State Street  
Jackson, Mississippi 39201

CODED

WATER WELL DRILLERS LOG

July 3 1973 *Chesapeake Lincoln*  
date well completed firm name county well located

LANDOWNER: *Thomas Clay*  
*H. S. Brookhaver*

description of formations encountered	from	to
<i>Clay</i>	<i>0</i>	<i>22</i>
<i>Red Sand</i>	<i>22</i>	<i>40</i>
<i>Red Sand</i>	<i>40</i>	<i>45</i>
<i>Sand &amp; gravel</i>	<i>45</i>	<i>64</i>

(mailing address)

WELL LOCATION:

sec. *25* T. *6* N. R. *9* E  
*0.7* miles *W* of *Bayou de l'Inde*  
(distance) (direction) (nearest town)

WELL PURPOSE: *Drain*  
(home, irrigation, municipal, industrial)

WELL COMPLETION DATA:

- (1) diameter (inches) *4"*
- (2) total depth (feet) *64*
- (3) static water level (feet) *39* below above top of ground.
- (4) casing *Plast Bottom*  
(material) (depth)

(size) If telescope see back.

- (5) screen *6'* *58'*  
(length) (depth to top)
- 4"* *Plast*  
(size) (material)

- (6) pump *By owner*  
(HP) (yield gpm)
- (type power)

- (7) electric log *No.*  
(yes or no)

(organization running log)

- (8) how well bottom plugged *wood plug*


DRILLERS REMARKS:  
*New location*

CODED

MAY 21 1974

If well telescopes please sketch and show depths.

GROUND LEVEL

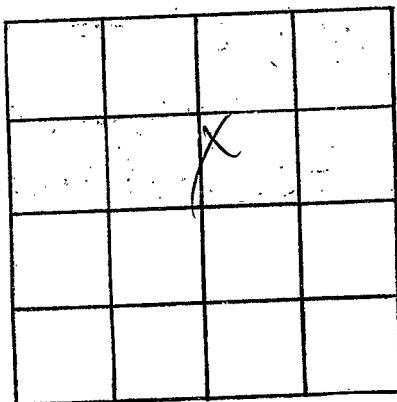

SECTION 25

Please indicate well location X.

ADDITIONAL INFORMATION

If more than one screen, show locations of each on sketch.