

LINCOLN

L21

9/16/74

MISSISSIPPI BOARD OF WATER COMMISSIONERS
416 North State Street
Jackson, Mississippi 39201

CODED

WATER WELL DRILLERS LOG

16 Sept 1974
date well completed

J.T. Carngta
firm name

Lincoln
county well located

LANDOWNER:

Dennis Alfred
Bogue Chitto
(mailing address)

description of formations encountered

Chaz
Red Soil
Sand

from to
0 15
15 35
35 60

WELL LOCATION:

sec. 19 T-6 N R-7 E
6 miles NW of B.C.
(distance) (direction) (nearest town)

WELL PURPOSE:

(home, irrigation, municipal, industrial)

CODED

WELL COMPLETION DATA:

- (1) diameter (inches) 4
- (2) total depth (feet) 68
- (3) static water level (feet) 50 below above top of ground.
- (4) casing pl 62
(material) (depth)
(size) if telescope see back.
- (5) screen 6 62
(length) (depth to top)
4 pl
(size) (material)
- (6) pump 1/2 8
(HP) (yield gpm)
shut
(type power)
- (7) electric log _____
(yes or no)

(organization running log)

(8) how well bottom plugged wood


RECEIVED

DEC - 3 1974

DRILLERS REMARKS:

If well telescopes please sketch and show depths.

GROUND LEVEL

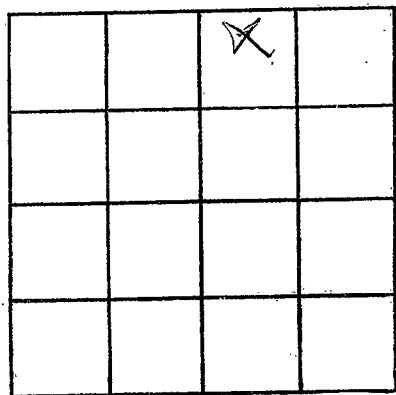

SECTION 19

Please indicate well location X.

ADDITIONAL INFORMATION

If more than one screen, show locations of each on sketch.