

LINCOLN
L24
9-15-79

MISSISSIPPI
BOARD OF WATER COMMISSIONERS
416 North State Street
Jackson, Mississippi 39201

CODED

WATER WELL DRILLERS LOG

9-15 79 Griner Drilling Lincoln
date well completed firm name county well located

LANDOWNER:	description of formations encountered	from	to
<u>Amoco Production</u>	<u>Fill dirt + clay</u>	<u>0</u>	<u>21</u>
<u>P.O. Box 51921</u>	<u>sand + pea gravel</u>	<u>21</u>	<u>60</u>
<u>Lafayette, La.</u>	<u>rock</u>	<u>60</u>	<u>147</u>
(mailing address)	<u>sand + pea gravel</u>	<u>147</u>	<u>231</u>
WELL LOCATION: <u>1550'S + 1140'W</u>	<u>clay + sand</u>	<u>231</u>	<u>273</u>
sec. <u>30</u> T. <u>6</u> R. <u>7</u> of	<u>sand</u>	<u>273</u>	<u>294</u>
<u>Brookhaven</u>	<u>clay</u>	<u>294</u>	<u>378</u>
(distance) (direction) (nearest town)	<u>clay + sand</u>	<u>378</u>	<u>500</u>
WELL PURPOSE: <u>oil field supply</u>	<u>sand + pea gravel</u>	<u>500</u>	<u>570</u>
(home, irrigation, municipal, industrial)	<u>clay + sand</u>	<u>570</u>	<u>609</u>

WELL COMPLETION DATA:

- diameter (inches) 4"
- total depth (feet) 609'
- static water level (feet) _____ below/above top of ground.
- casing steel, 570'
(material) (depth)
4"
(size) If telescope see back.
- screen 42, 528'
(length) (depth to top)
4", perforated
(size) (material)
- pump _____ 80
(HP) (yield gpm)
AC
(type power)
- electric log _____
(yes or no)

(organization running log)

- how well bottom plugged orange peel

DRILLERS REMARKS:

CODED


DEPT. OF NATURAL RESOURCES
MISSISSIPPI BOARD OF LAND & WATER RESOURCES

OCT 20 1979

RECEIVED

If well telescopes please sketch and show depths.

GROUND LEVEL

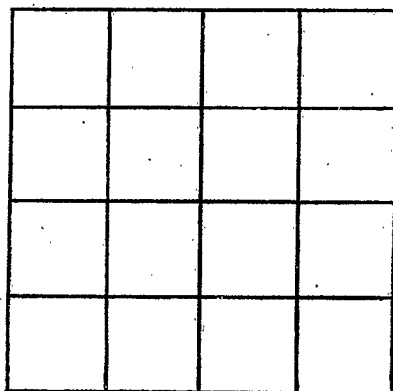

SECTION _____

Please indicate well location X.

ADDITIONAL INFORMATION

If more than one screen,
show locations of each on sketch.