

MISSISSIPPI DEPARTMENT OF NATURAL RESOURCES

Bureau of Land and Water Resources

Southport Mall

P.O. Box 10631

Jackson, Mississippi 39209

WATER WELL DRILLERS LOG

Griner Drilling Service, Inc.

Lincoln

E26
 LINCOLN
 5-10-84

CODED

5-10-84 date well completed

Griner Drilling Service, Inc. firm name

Lincoln county well located

LANDOWNER:	description of formations encountered	from	to
See Land Drilling Co. 900 Dunn St. Houma, La. (mailing address)	clay, sand, pea gravel	0	230
WELL LOCATION: 1704' N + 574' W sec. 20 T 6 N R 7 E SE 100	sand, pea gravel	230	273
No. 1 Smith et al. Hearts 20 mi. Brookhaven distance (direction) of (nearest town)			
WELL PURPOSE: oil field supply (home, irrigation, municipal, industrial)			
WELL COMPLETION DATA:			
(1) diameter (inches) 3"			
(2) total depth (feet) 273'			
(3) static water level (feet) 75' below top of ground.			
(4) casing steel, 273' (material) (depth)			
3" (size) If telescope see back.			
(5) screen 42' (length), 231' (depth to top)			
3" (size), perforated (material)			
(6) pump - (HP) 75-80 (yield gpm)			
AC (type power)			
(7) electric log (yes or no)			
(organization running log)			
(8) how well bottom plugged orange peel			

DEPT. OF NATURAL RESOURCES
 BUREAU OF LAND & WATER RESOURCES


MAY 21 1984

RECEIVED

DRILLERS REMARKS:

If well telescopes please
sketch and show depths.

GROUND LEVEL

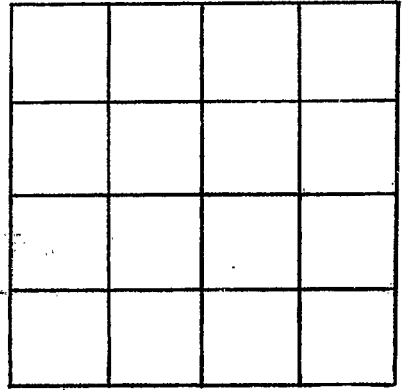

SECTION _____

Please indicate well location X.

ADDITIONAL INFORMATION

If more than one screen,
show locations of each on sketch.