

LINCOLN  
L 28

MISSISSIPPI DEPARTMENT OF NATURAL RESOURCES  
Bureau of Land and Water Resources  
Southport Mall  
P.O. Box 10631  
Jackson, Mississippi 39209  
WATER WELL DRILLERS LOG

CODED

8-12 19 84 Grenn Water Well Lincoln  
date well completed firm name county well located

LANDOWNER: Roger Smith  
Rt. 5  
Brookhaven, Ms.  
(mailing address)

description of formations encountered	from	to
Clay	1	20
sand & gravel	20	60
white clay	60	75
sand	75	84
white clay	84	105
sand	105	218

WELL LOCATION:  
sec. 7 T 6 N R 7 E  
6 miles SW of Brookhaven  
(distance) (direction) (nearest town)

WELL PURPOSE: home  
(home, irrigation, municipal, industrial)

CODED

WELL COMPLETION DATA:  
(1) diameter (inches) 4  
(2) total depth (feet) 218  
(3) static water level (feet) 84 below above top of ground.  
(4) casing PVC 198  
(material) (depth)  
4" if telescope see back.  
(size)  
(5) screen 20' 198'  
(length) (depth to top)  
.010 PVC  
(size) (material)  
(6) pump 3 hp sub 35  
(HP) (yield gpm)  
electricity  
(type power)  
(7) electric log no  
(yes or no)  
(organization running log)

(8) how well bottom plugged  
back wash valve

DRILLERS REMARKS:


DEPT. OF NATURAL RESOURCES  
BUREAU OF LAND & WATER RESOURCES

SEP 18 1984

RECEIVED

If well telescopes please sketch and show depths.

GROUND LEVEL

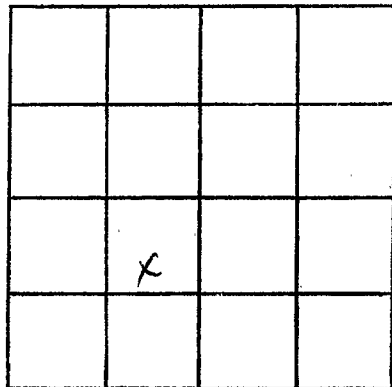

SECTION 7

Please indicate well location X.

ADDITIONAL INFORMATION

If more than one screen,  
show locations of each on sketch.