

LINCOLN  
~~LINCOLN~~  
 L29

MISSISSIPPI DEPARTMENT OF NATURAL RESOURCES  
 Bureau of Land and Water Resources  
 Southport Mall  
 P.O. Box 10631  
 Jackson, Mississippi 39209  
 WATER WELL DRILLERS LOG

CODED

11-29 1984 Grenn Water Well Lincoln  
 date well completed firm name county well located

LANDOWNER: A.C. Rushing

description of fomations encountered

from to

Rt. 2, Box 74  
 Brookhaven, Ms.  
 (mailing address)

Clay	1	20
sand & gravel	20	25
white clay	25	45
blue clay	45	170
white clay	170	175
sand	175	212

WELL LOCATION:

sec. k2 T 6 N R 7 E  
 S W  
 3 miles N of Bogue Chitto  
 (distance) (direction) (nearest town)

CODED

WELL PURPOSE: home  
 (home, irrigation, municipal, industrial)

WELL COMPLETION DATA:

- (1) diameter (inches) 4
- (2) total depth (feet) 212
- (3) static water level (feet) 38 below above top of ground.
- (4) casing PVC 202  
 (material) (depth)  
4" If telescope see back.  
 (size)
- (5) screen 10' 202'  
 (length) (depth to top)  
.010 PVC  
 (size) (material)
- (6) pump 1 sub 10  
 (HP) (yield gpm)  
electricity  
 (type power)
- (7) electric log no  
 (yes or no)

(organization running log)

- (8) how well bottom plugged Back wash valve

RECEIVED


APR 17 1985

DRILLERS REMARKS:

Department of Natural Resources  
 Bureau of Land & Water Resources

If well telescopes please sketch and show depths.

GROUND LEVEL

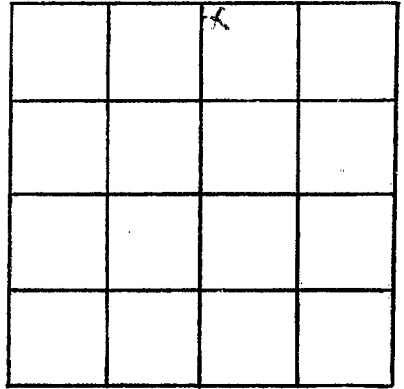

SECTION 13

Please indicate well location X.

ADDITIONAL INFORMATION

If more than one screen,  
show locations of each on sketch.