

LINCOLN
#230

MISSISSIPPI DEPARTMENT OF NATURAL RESOURCES
Bureau of Land and Water Resources
Southport Mall
P.O. Box 10631
Jackson, Mississippi 39209
WATER WELL DRILLERS LOG

CODED

10-3-84 19 Grenn Water Well Lincoln
date well completed firm name county well located

LANDOWNER: Joe Scroggins	description of formations encountered	from	to
P.O. Box 22			
Brookhaven, Ms.	Sand & gravel	20	55
(mailing address)	White Clay	55	70
WELL LOCATION:	Blue Clay	70	120
sec. 2 T. 6 N. R. 7 E.	White clay	120	125
	Sand	125	178

3 miles S of Brookhaven
(distance) (direction) (nearest town)

WELL PURPOSE: home
(home, irrigation, municipal, industrial)

WELL COMPLETION DATA:

- (1) diameter (inches) 4
- (2) total depth (feet) 178
- (3) static water level (feet) 56 below above top of ground.
- (4) casing Pvc, 158' (material) (depth)
4" (size) if telescope see back.
- (5) screen 20', 158' (length) (depth to top)
.010, PVC (size) (material)
- (6) pump 1 HP, 10 (HP) (yield gpm)
- electricity (type power)
- (7) electric log no (yes or no)
(organization running log)
- (8) how well bottom plugged back wash valve

CODED


RECEIVED
APR 7 1985

Department of Natural Resources
Bureau of Land & Water Resources

DRILLERS REMARKS:

If well telescopes please sketch and show depths.

GROUND LEVEL

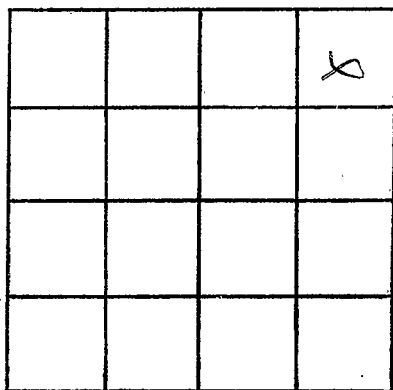

SECTION 2

Please indicate well location X.

ADDITIONAL INFORMATION

If more than one screen,
show locations of each on sketch.