

| |
|---------|
| LINCOLN |
| L 31 |
| 4-19-85 |
| |
| |

MISSISSIPPI DEPARTMENT OF NATURAL RESOURCES
Bureau of Land and Water Resources
Southport Mall
P.O. Box 10631
Jackson, Mississippi 39209
WATER WELL DRILLERS LOG

April 19 19 85 Grenn Water Well Lincoln
date well completed firm name county well located

| | | | | | | |
|--|---------------------------------------|------|----|------------|---|----|
| LANDOWNER: Tim Dixon | description of formations encountered | from | to | | | |
| Rt. 2, Box 72 | | | | Citronelle | 1 | 52 |
| Bogue Chitto, Ms. (mailing address) | | | | | | |
| WELL LOCATION: sec. 13 T 6 <u>(N)</u> R 7 <u>(E)</u> S W | | | | | | |
| 4 miles North of Bogue Chitto (distance) (direction) (nearest town) | | | | | | |
| WELL PURPOSE: home (home, irrigation, municipal, industrial) | | | | | | |
| WELL COMPLETION DATA: | | | | | | |
| (1) diameter (inches) 4 | | | | | | |
| (2) total depth (feet) 52 | | | | | | |
| (3) static water level (feet) 39 below above top of ground. | | | | | | |
| (4) casing PVC 42 (material) (depth) 4" if telescope see back. (size) | | | | | | |
| (5) screen 10' 42' (length) (depth to top) .010 PVC (size) (material) | | | | | | |
| (6) pump 1/2 sub 8 (HP) (yield gpm) electricity (type power) | | | | | | |
| (7) electric log no (yes or no) (organization running log) | | | | | | |
| (8) how well bottom plugged back wash valve | | | | | | |


RECEIVED

MAY 17 1985

DRILLERS REMARKS: Department of Natural Resources
Bureau of Land & Water Resources

If well telescopes please sketch and show depths.

GROUND LEVEL

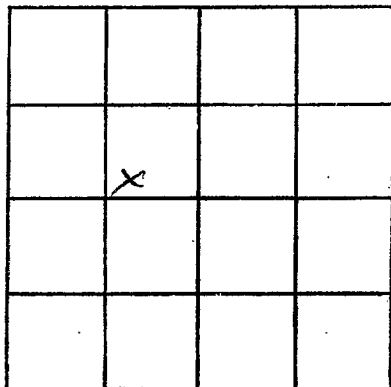

SECTION 23

Please indicate well location X.

ADDITIONAL INFORMATION

If more than one screen,
show locations of each on sketch.